


04-159-X

RAMSEY AREA 32

2/3

10-20-1 SINGLE IDLER

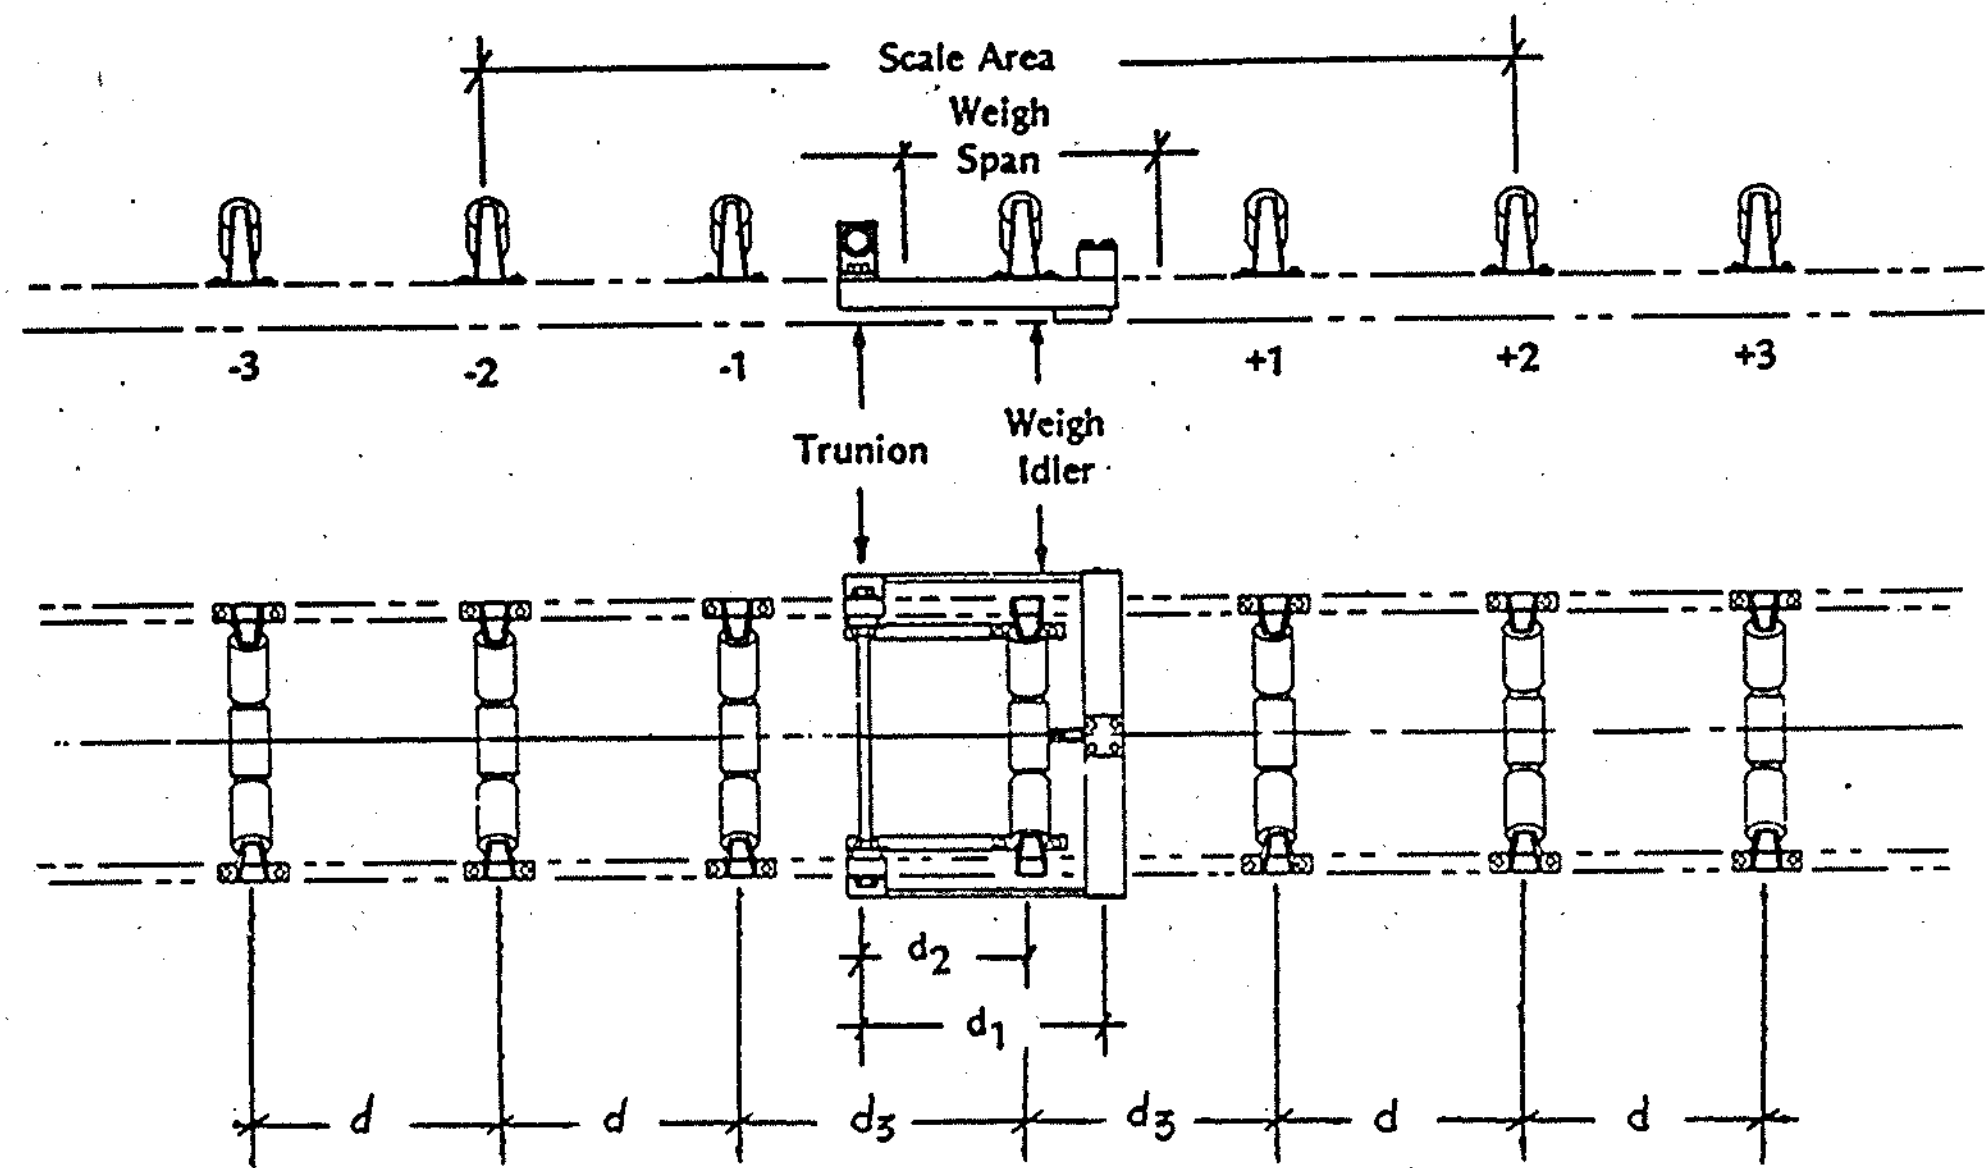

$d = 625 \pm 3$ $d_2 = 572$
 $d_1 = 813$ $d_3 = 1290 \pm 3$

LAS MEDIDAS ESTAN EN MILIMETROS

DIAGRAMA DE INSTALACION			R.E
PUENTES DE PESAJE RAMSEY			RCV
32-WIT-1101/1201/1301/101.			0
PROY 032-161-90	2 de 5	RAMSEY	
AREA 32	E-6933	FACIA 10-02-92	

04-159-XX

RAMSEY

Cell	15	10K	25K	50K	100K	150K	165K	200K	249K	348K	499K
100 lb		286.65	115.86	58.13	29.12	19.422	17.658	14.57	11.705	8.377	5.843
250 lb		716.63	289.64	145.32	72.79	48.55	44.145	36.43	29.263	20.943	14.607
500 lb		1433.25	579.28	290.65	145.58	97.11	88.290	72.85	58.526	41.885	29.215
1000 lb		2866.5	1158.56	581.30	291.16	194.22	176.580	145.71	117.053	83.770	58.430
2500 lb		7166.26	2896.39	1453.25	727.89	485.54	441.451	364.26	292.632	209.425	146.074

$$\text{Equiv. lbs. at Load Cell} = \frac{\text{L.C.S.}}{2K} \left(\frac{1}{\frac{2RS}{R1} + 1} \right)$$

L.C.S. = Load Cell Size

K = V/V Sensitivity (.003 for USP Revere)

RS = Shunt Value

R1 = 350

$$\text{Equiv. lbs./ft. Loading} = \frac{\text{Equiv. lbs. at Load Cell}}{\text{Cos } \phi \text{ of incline}} \times \frac{D_1}{d_2} \times \frac{1}{\text{Weigh Span (ft.)}}$$

d_1 = Centerline of rear trunnion to centerline of loadcell distance in inches.


d_2 = Centerline of rear trunnion to centerline of weigh idler distance in inches.

Refer to Figure 4-5.

NOTE

The tabulated resistor date is for reference only: For actual resistance, refer to Section 4.4.7 (1)

RE 10/02/92

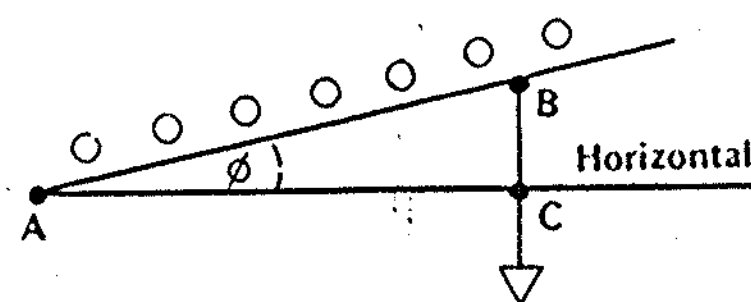

Angle ϕ = Angle of Incline

$$\text{COS } \phi = \frac{\text{Distance AC}}{\text{Distance AB}}$$

Choose a convenient distance 'AB' and measure it in inches.

Hang a plumb line from 'B'.

Measure the horizontal distance from 'A' to plumb line in inches ('AC').

Divide 'AC' by 'AB' to get COS ϕ .

If angle of incline in degrees is known, use the following table:-

Angle O	Cos O
0	1.0000
1	.9998
2	.9994
3	.9986
4	.9976
5	.9962

Angle O	Cos O
6	.9945
7	.9925
8	.9903
9	.9877
10	.9848
11	.9816


Angle O	Cos O
12	.9781
13	.9744
14	.9703
15	.9659
16	.9613
17	.9563

RAMSEY

3 de 5


3/5

ITEM	PART NO	QTY	DESCRIPTION	DWG NO/SPEC
------	---------	-----	-------------	-------------

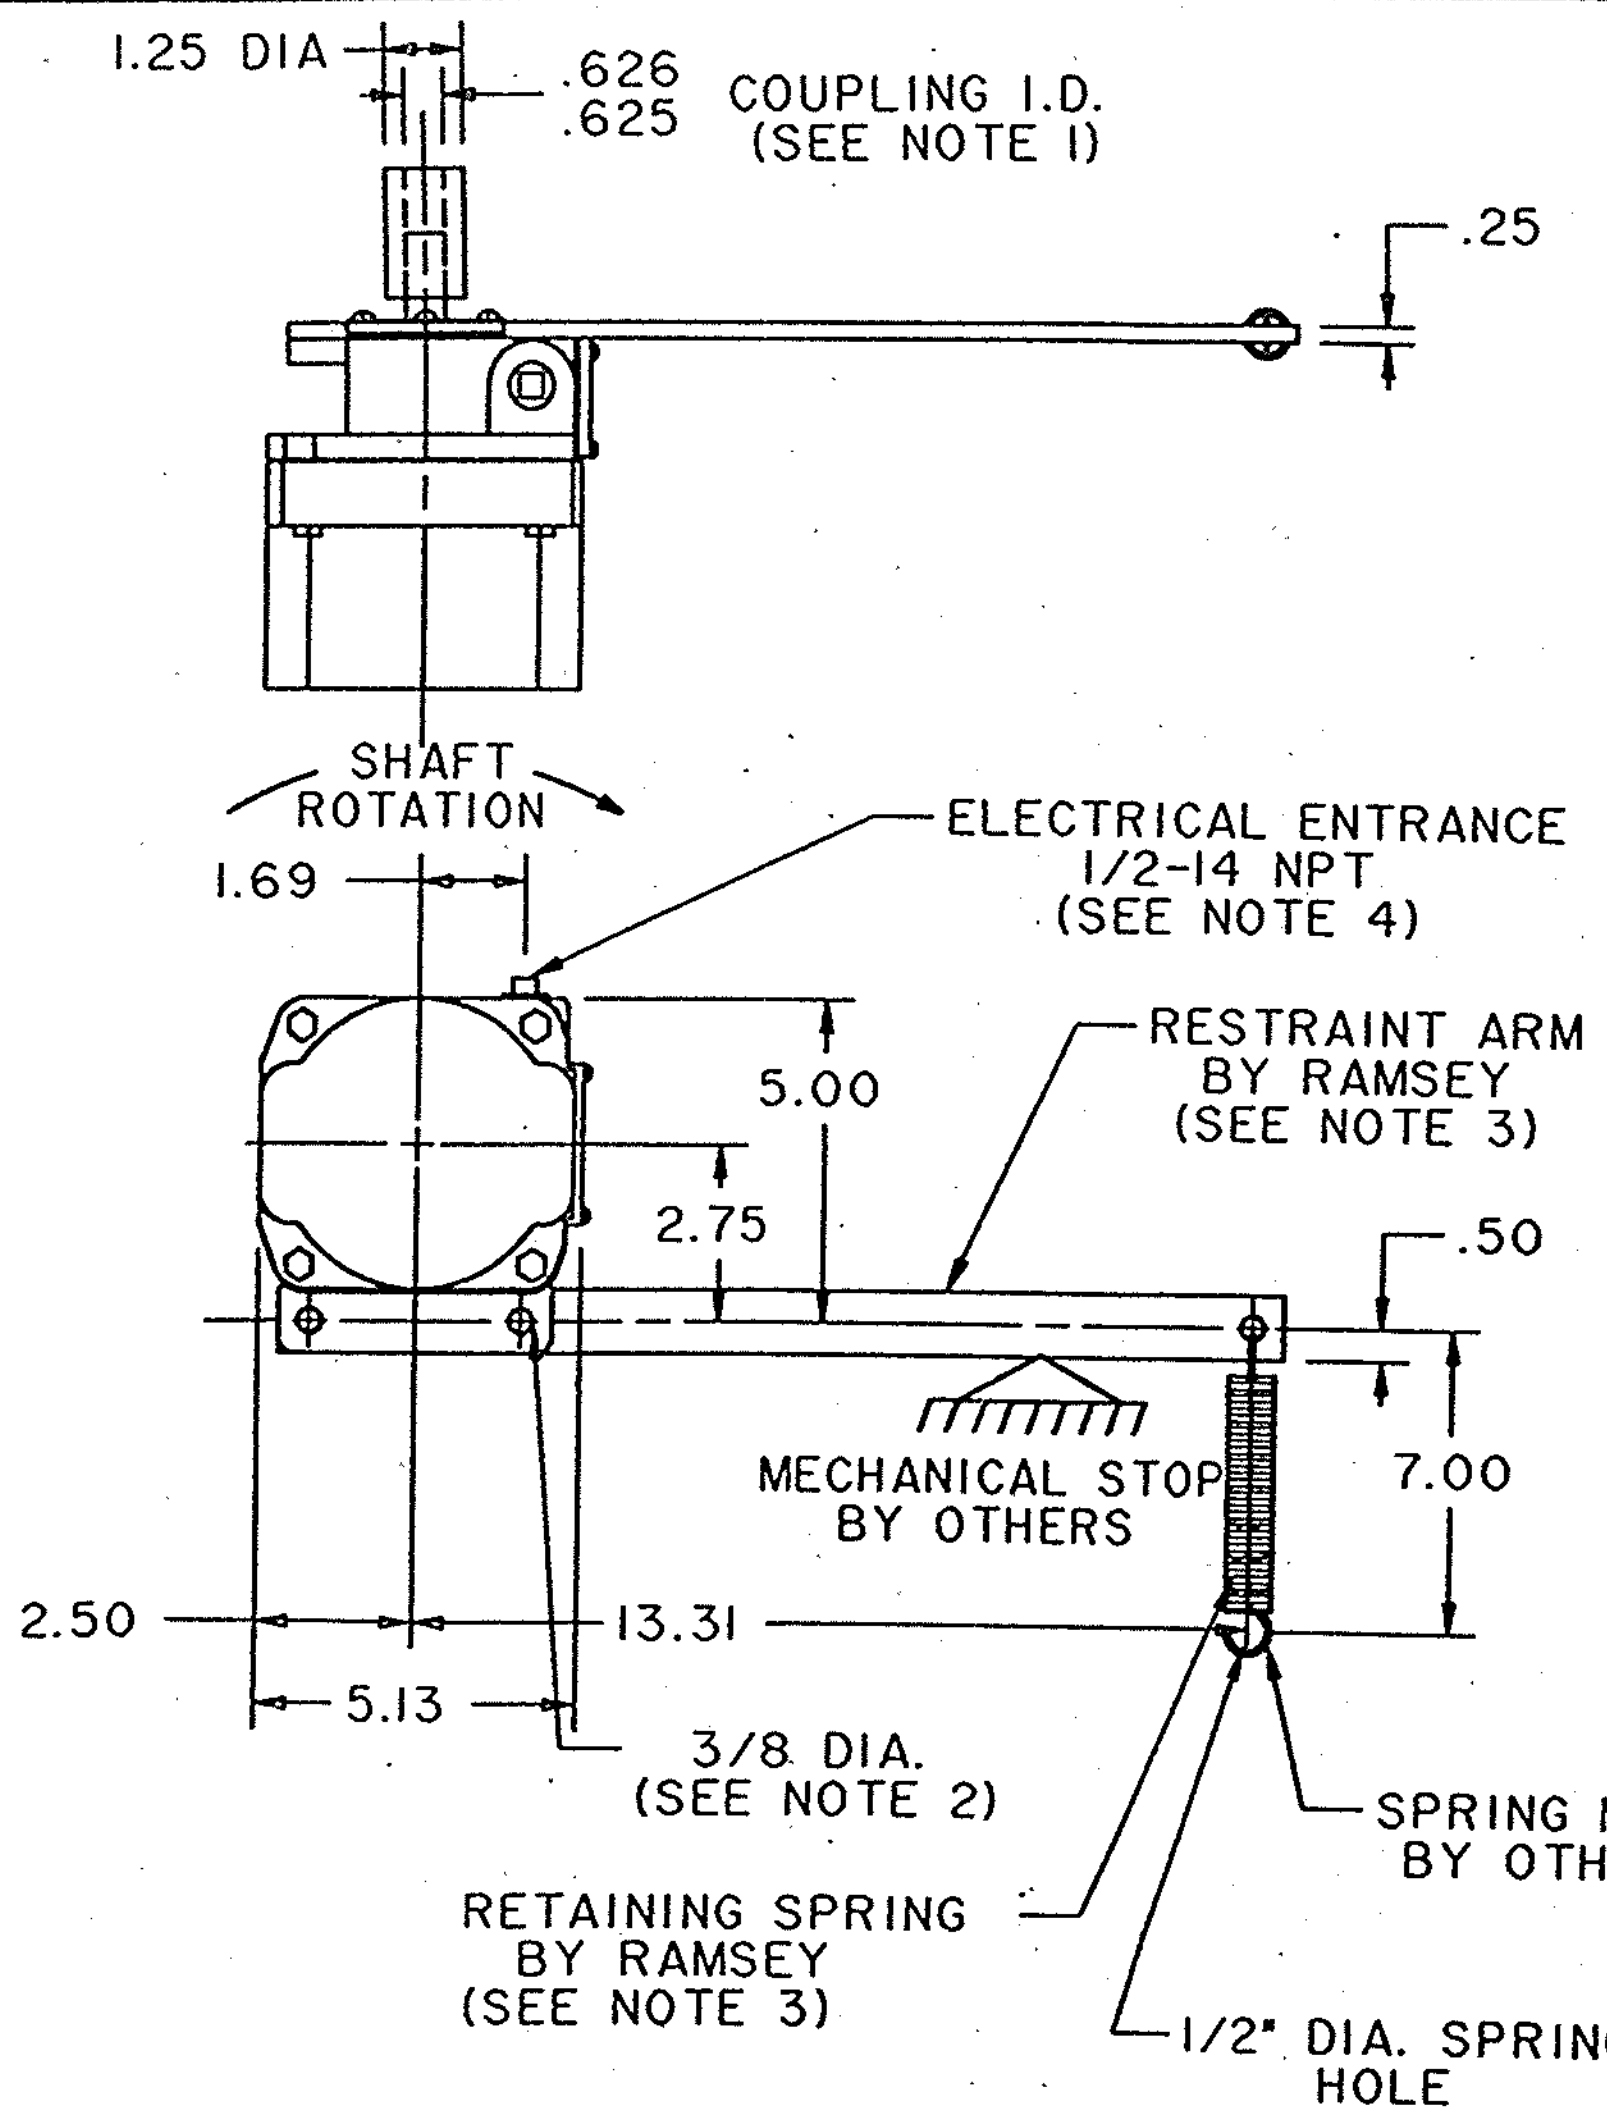

NOTE:

1. SPEED SENSOR TO BE DRIVEN BY CONVEYOR TAIL PULLEY. SPEED SENSOR MAX. INPUT RPM = 200, MIN. INPUT RPM = 20. CUSTOMER TO PROVIDE .624/.623 DIA. STUB SHAFT EXTENDING 2" FROM TAIL PULLEY SHAFT. SPEED SENSOR MUST BE COUPLED DIRECTLY TO STUB SHAFT.
2. ALL HARDWARE USED TO MOUNT RESTRAINT ARM TO SPEED SENSOR SUPPLIED BY OTHERS.
3. SPEED SENSOR MUST NOT BE MOUNTED RIGID. USE RESTRAINT ARM AND RETAINING SPRING TO KEEP SPEED SENSOR FROM ROTATING. MECHANICAL STOP AND SPRING MOUNT BY OTHERS.
4. ALL WIRING BY OTHERS IN ACCORDANCE WITH SYSTEM FIELD WIRING DIAGRAM.

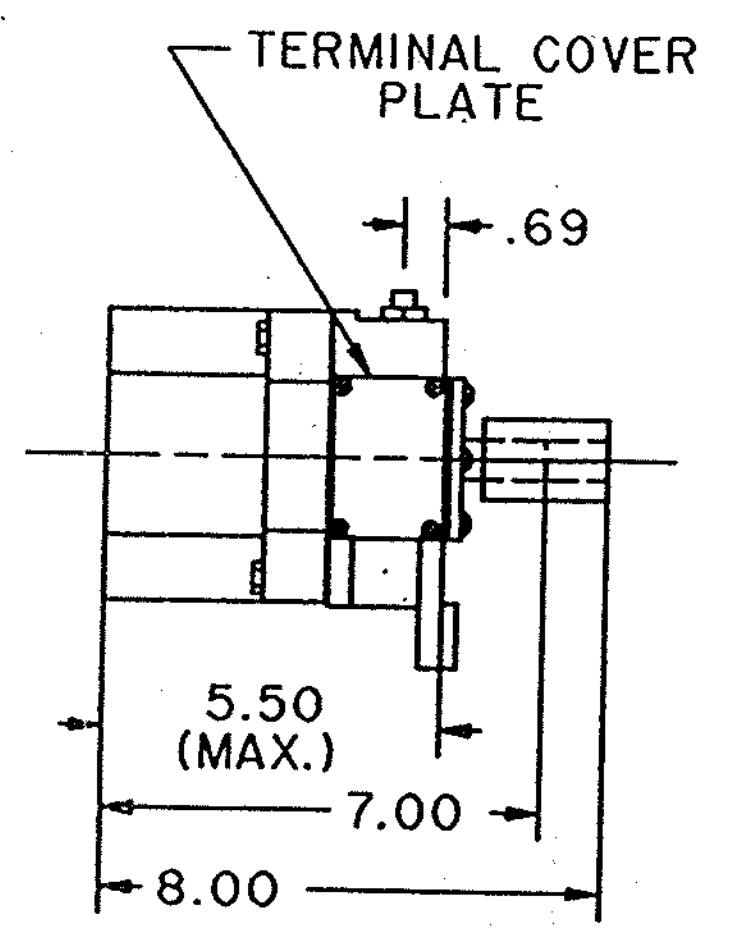

CADD DATABASE: CV CADD54X

DO NOT SCALE DWG REMOVE ALL BURRS AND UNNECESSARY SHARP EDGES		SCALE 1/4	
TOLERANCE UNLESS SPECIFIED		ENGINEER	DATE
.X	± .06	NBH	4-20-76
.XX	± .03	DRAWN	DATE
.XXX	± .015	LEB	4-20-76
FRACTIONS	± 1/16	CHECKER	DATE
ANGLES	± 1/2°	NBH	5-28-76
NEXT ASS'Y			
CUST ORDER NO			
CUSTOMER LOCATION			
USER LOCATION			

This document is confidential and is the property of Ramsey Technology Inc. ("Ramsey"). It may not be copied or reproduced in any way without the expressed written consent of Ramsey. This document also is an unpublished work of Ramsey. Ramsey intends to and is maintaining the work as confidential information. Ramsey also may seek to protect this work as an unpublished copyright. In the event of either invention or deliberate publication, Ramsey intends to enforce its rights to this work under the copyright laws as a published work. Those having access to this work may not copy, use or disclose the information in this work unless expressly authorized by Ramsey.

RAMSEY TECHNOLOGY INC.
1853 W. County Road C • St. Paul, Minnesota 55113 • Phone (612) 633-5150
A Beter Hughes Company

**OUTLINE AND INSTALLATION
DIAGRAM
SPEED SENSOR
MODEL 60-12**

DRAWING NUMBER		R.V
4 of 5	B4780F-0004	B

B		RL6	DRAWN IN CAD	9-6-90	CLJ
A			CORRECTED NOTES ON SPEED SENSOR	8-16-83	WWR
REV	ECO NO	MICRO	DESCRIPTION	DATE	BY
					APPD


4

3

2

1

13-04-159-XX
 Ramsey
 134380F-0004
 4/14

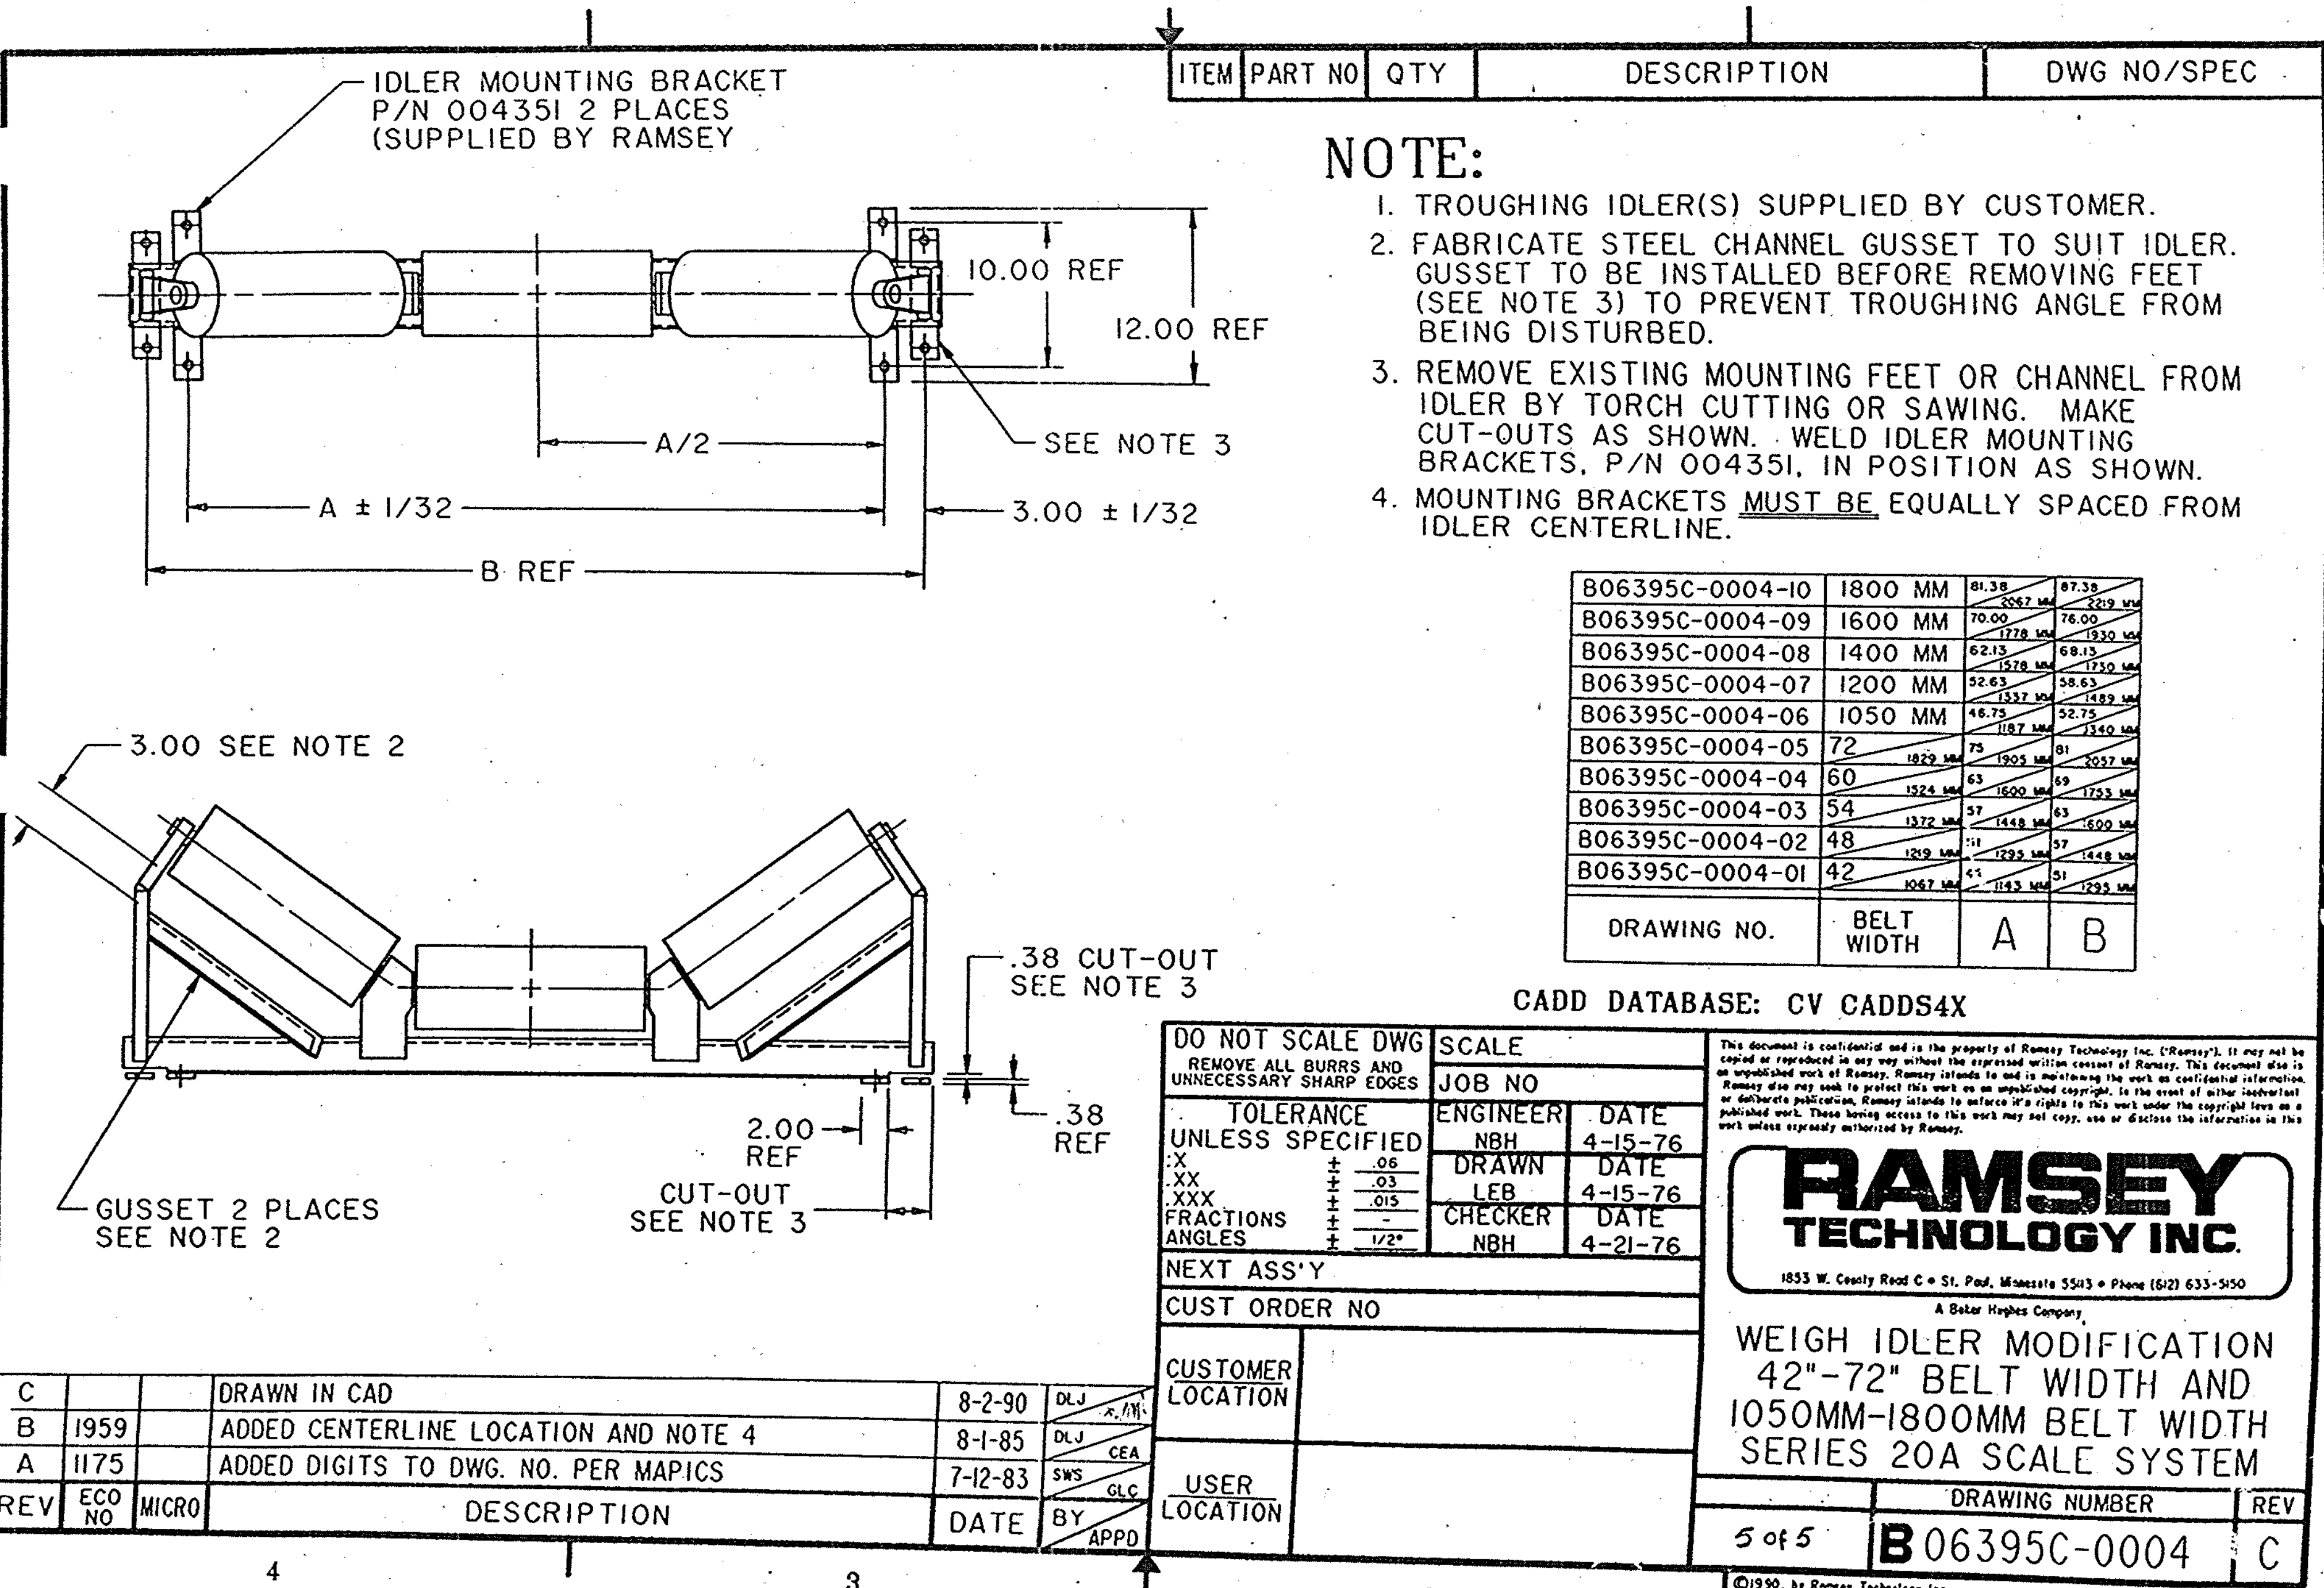


B-04-159-X

RAMSEY
B06395C-0004

5/1

CAJA TERMINAL
CT 32-1A

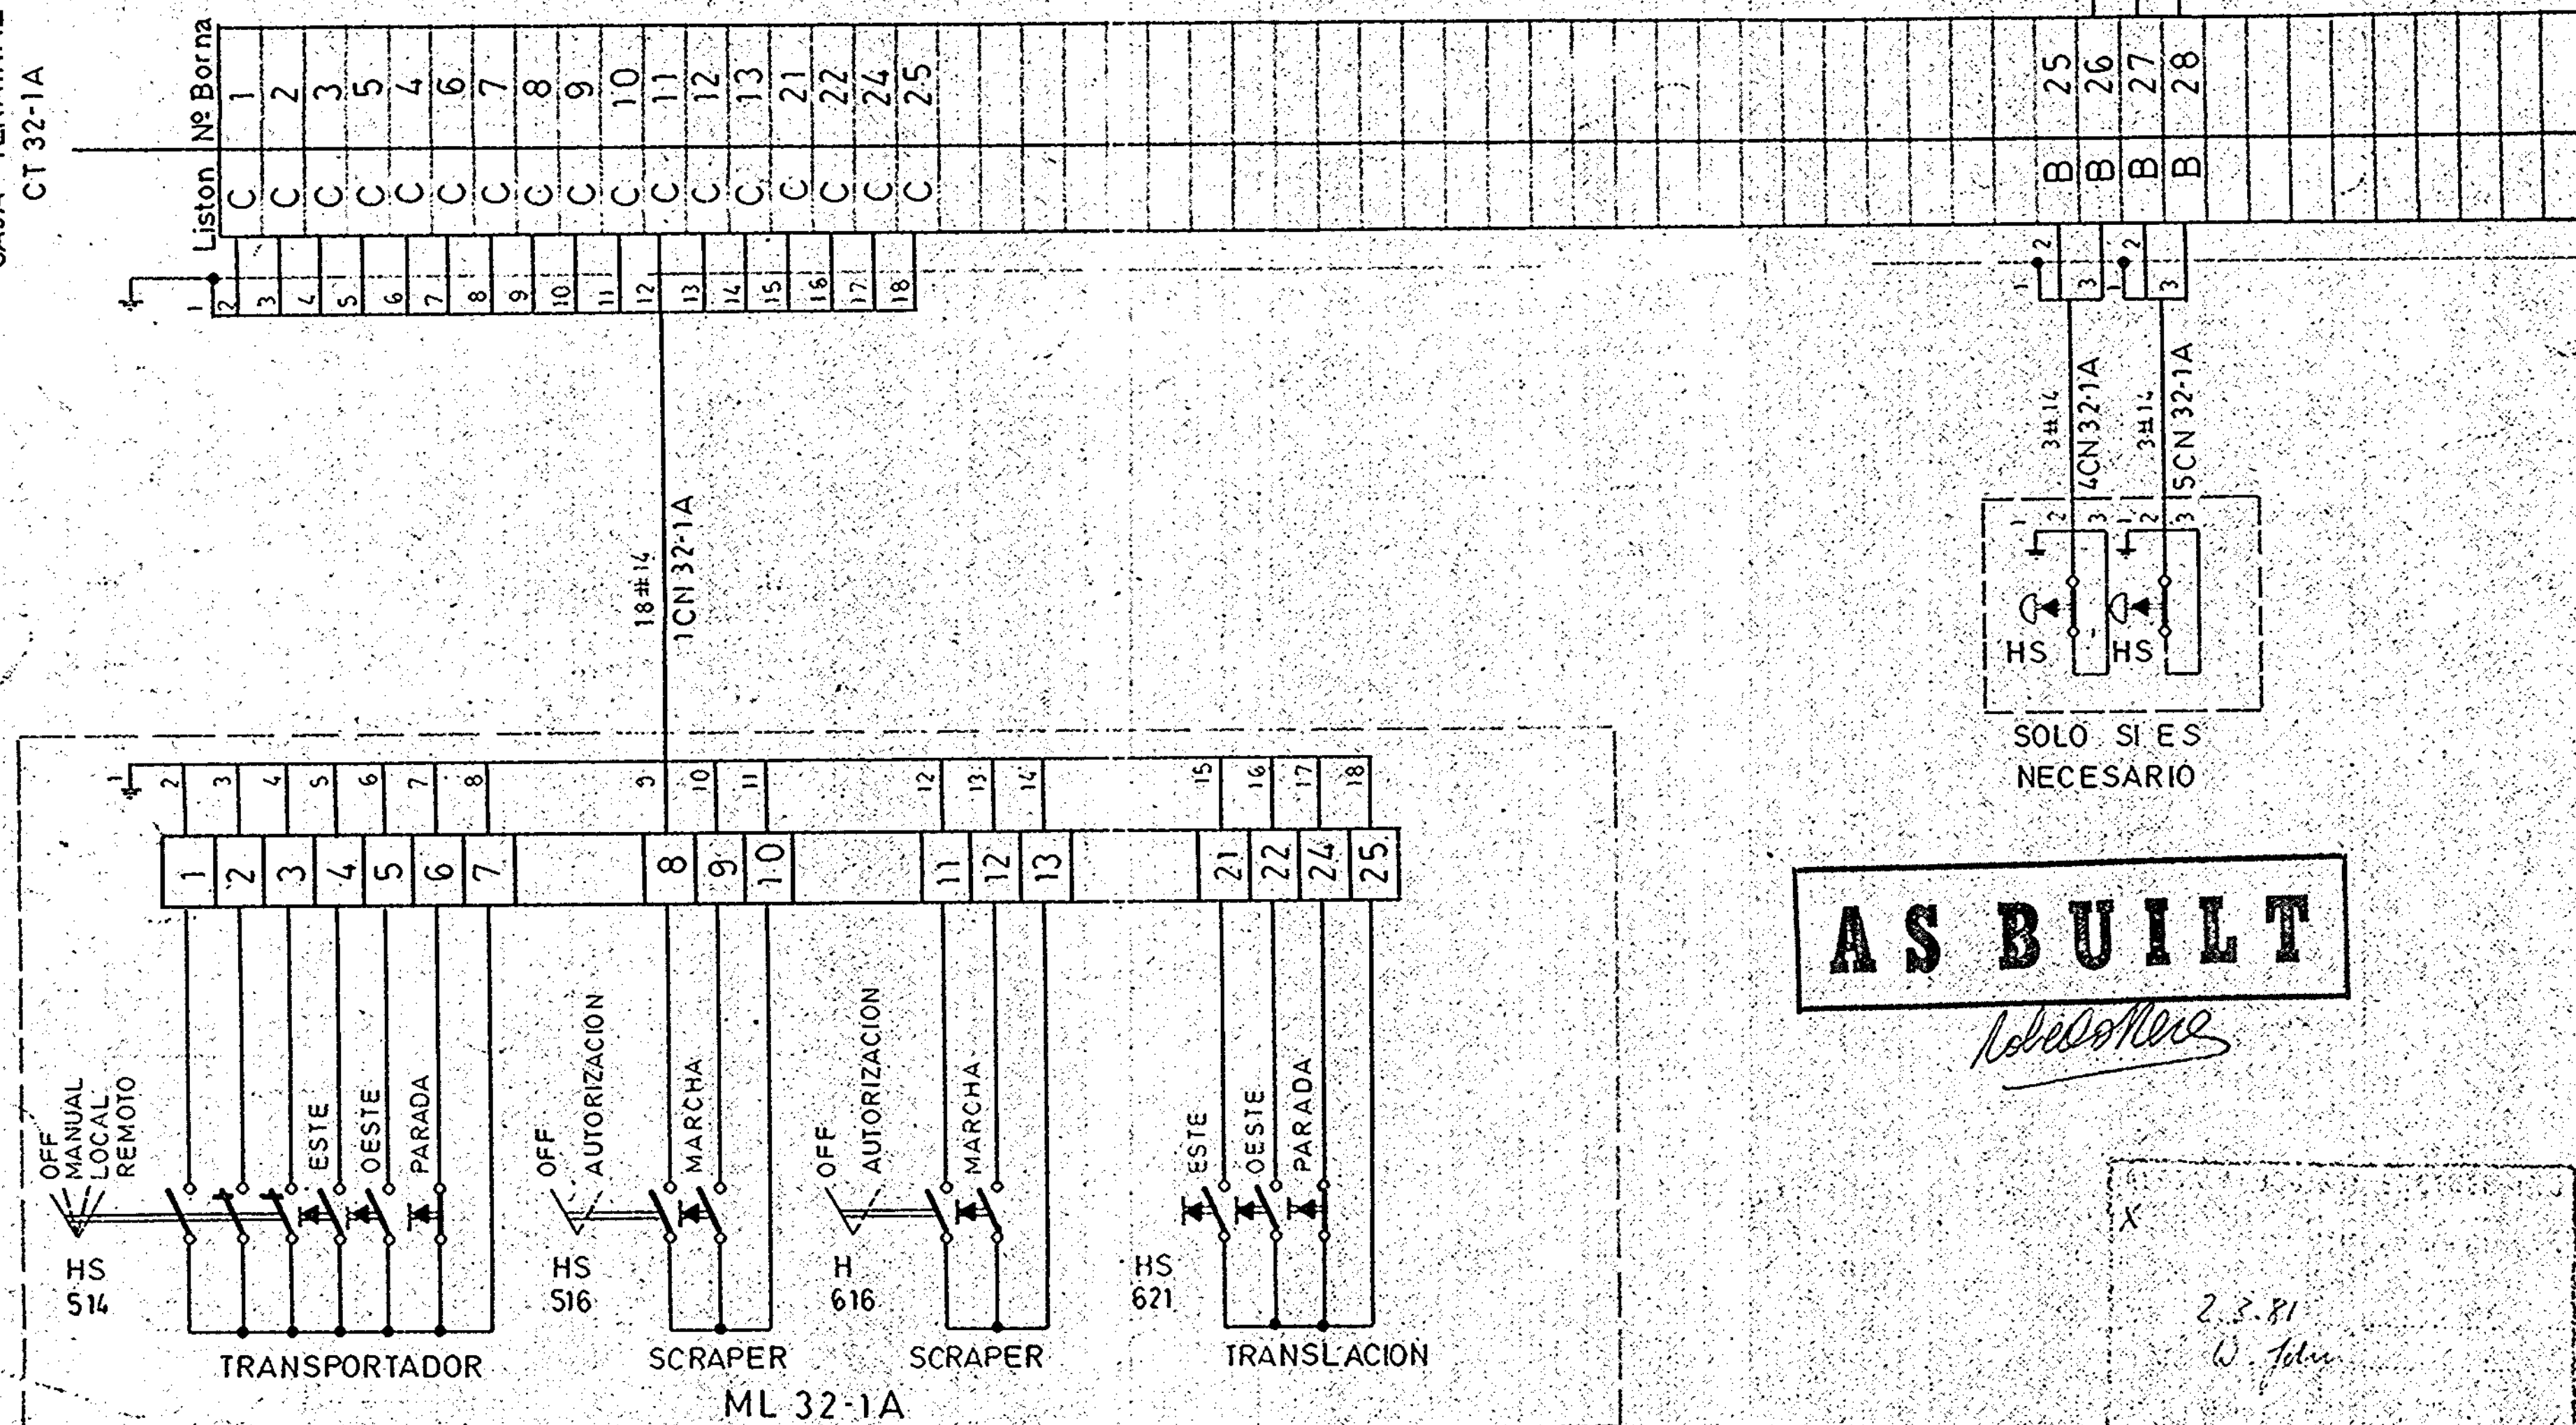

AS BUILT

Roberto Perez

SOLO SI ES
NECESARIO


2.3.81
W. J. J. J.

REV. NO.	FECHA DATE.	REVISION	FOR BY	APPROB. APP.	DIBUJOS DE REFERENCIA REFERENCE DRAWINGS	NUMERO DE DIBUJO DRAWING NUMBER	APROBACION APPROVED	FECHA DATE	
Δ 39-82		"AS BUILT"							
Δ									
Δ									
Δ									
					PROYECTO INTERALUMINA CIUDAD GUAYANA, VENEZUELA		DISEÑO DESIGNED <i>AP</i> 3/10/82 DIBUJO DRAWN <i>P. J. J.</i> 19-11-82 CONTROL CHECKED <i>W. J. J.</i> 7-1-81 APROBACION APPROVED	TITULO DEL DIBUJO DIA GRAMA DE INTERCONEXION DE INSTRUMENTOS CN 32-1A	
					ALESA ALUSUISSE ENGINEERING C.A. ZURICH SUIZA POR Y A NOMBRE DE INTERALUMINA C.A. CIUDAD GUAYANA VENEZUELA.		NUMERO DE DIBUJO DE INTERALUMINA 0159 1032:9 11622		
					CONTRATISTA / CONTRACTOR MECANICAS ASOCIADAS S.A.		NUMERO DE DIBUJO DEL CONTRATISTA HOJA 1 DE 2		

B-04-159-X
 17-0159.0.32:9.1622-2

13-04-159-XA

13-0159.0.32.9.1622 2/2

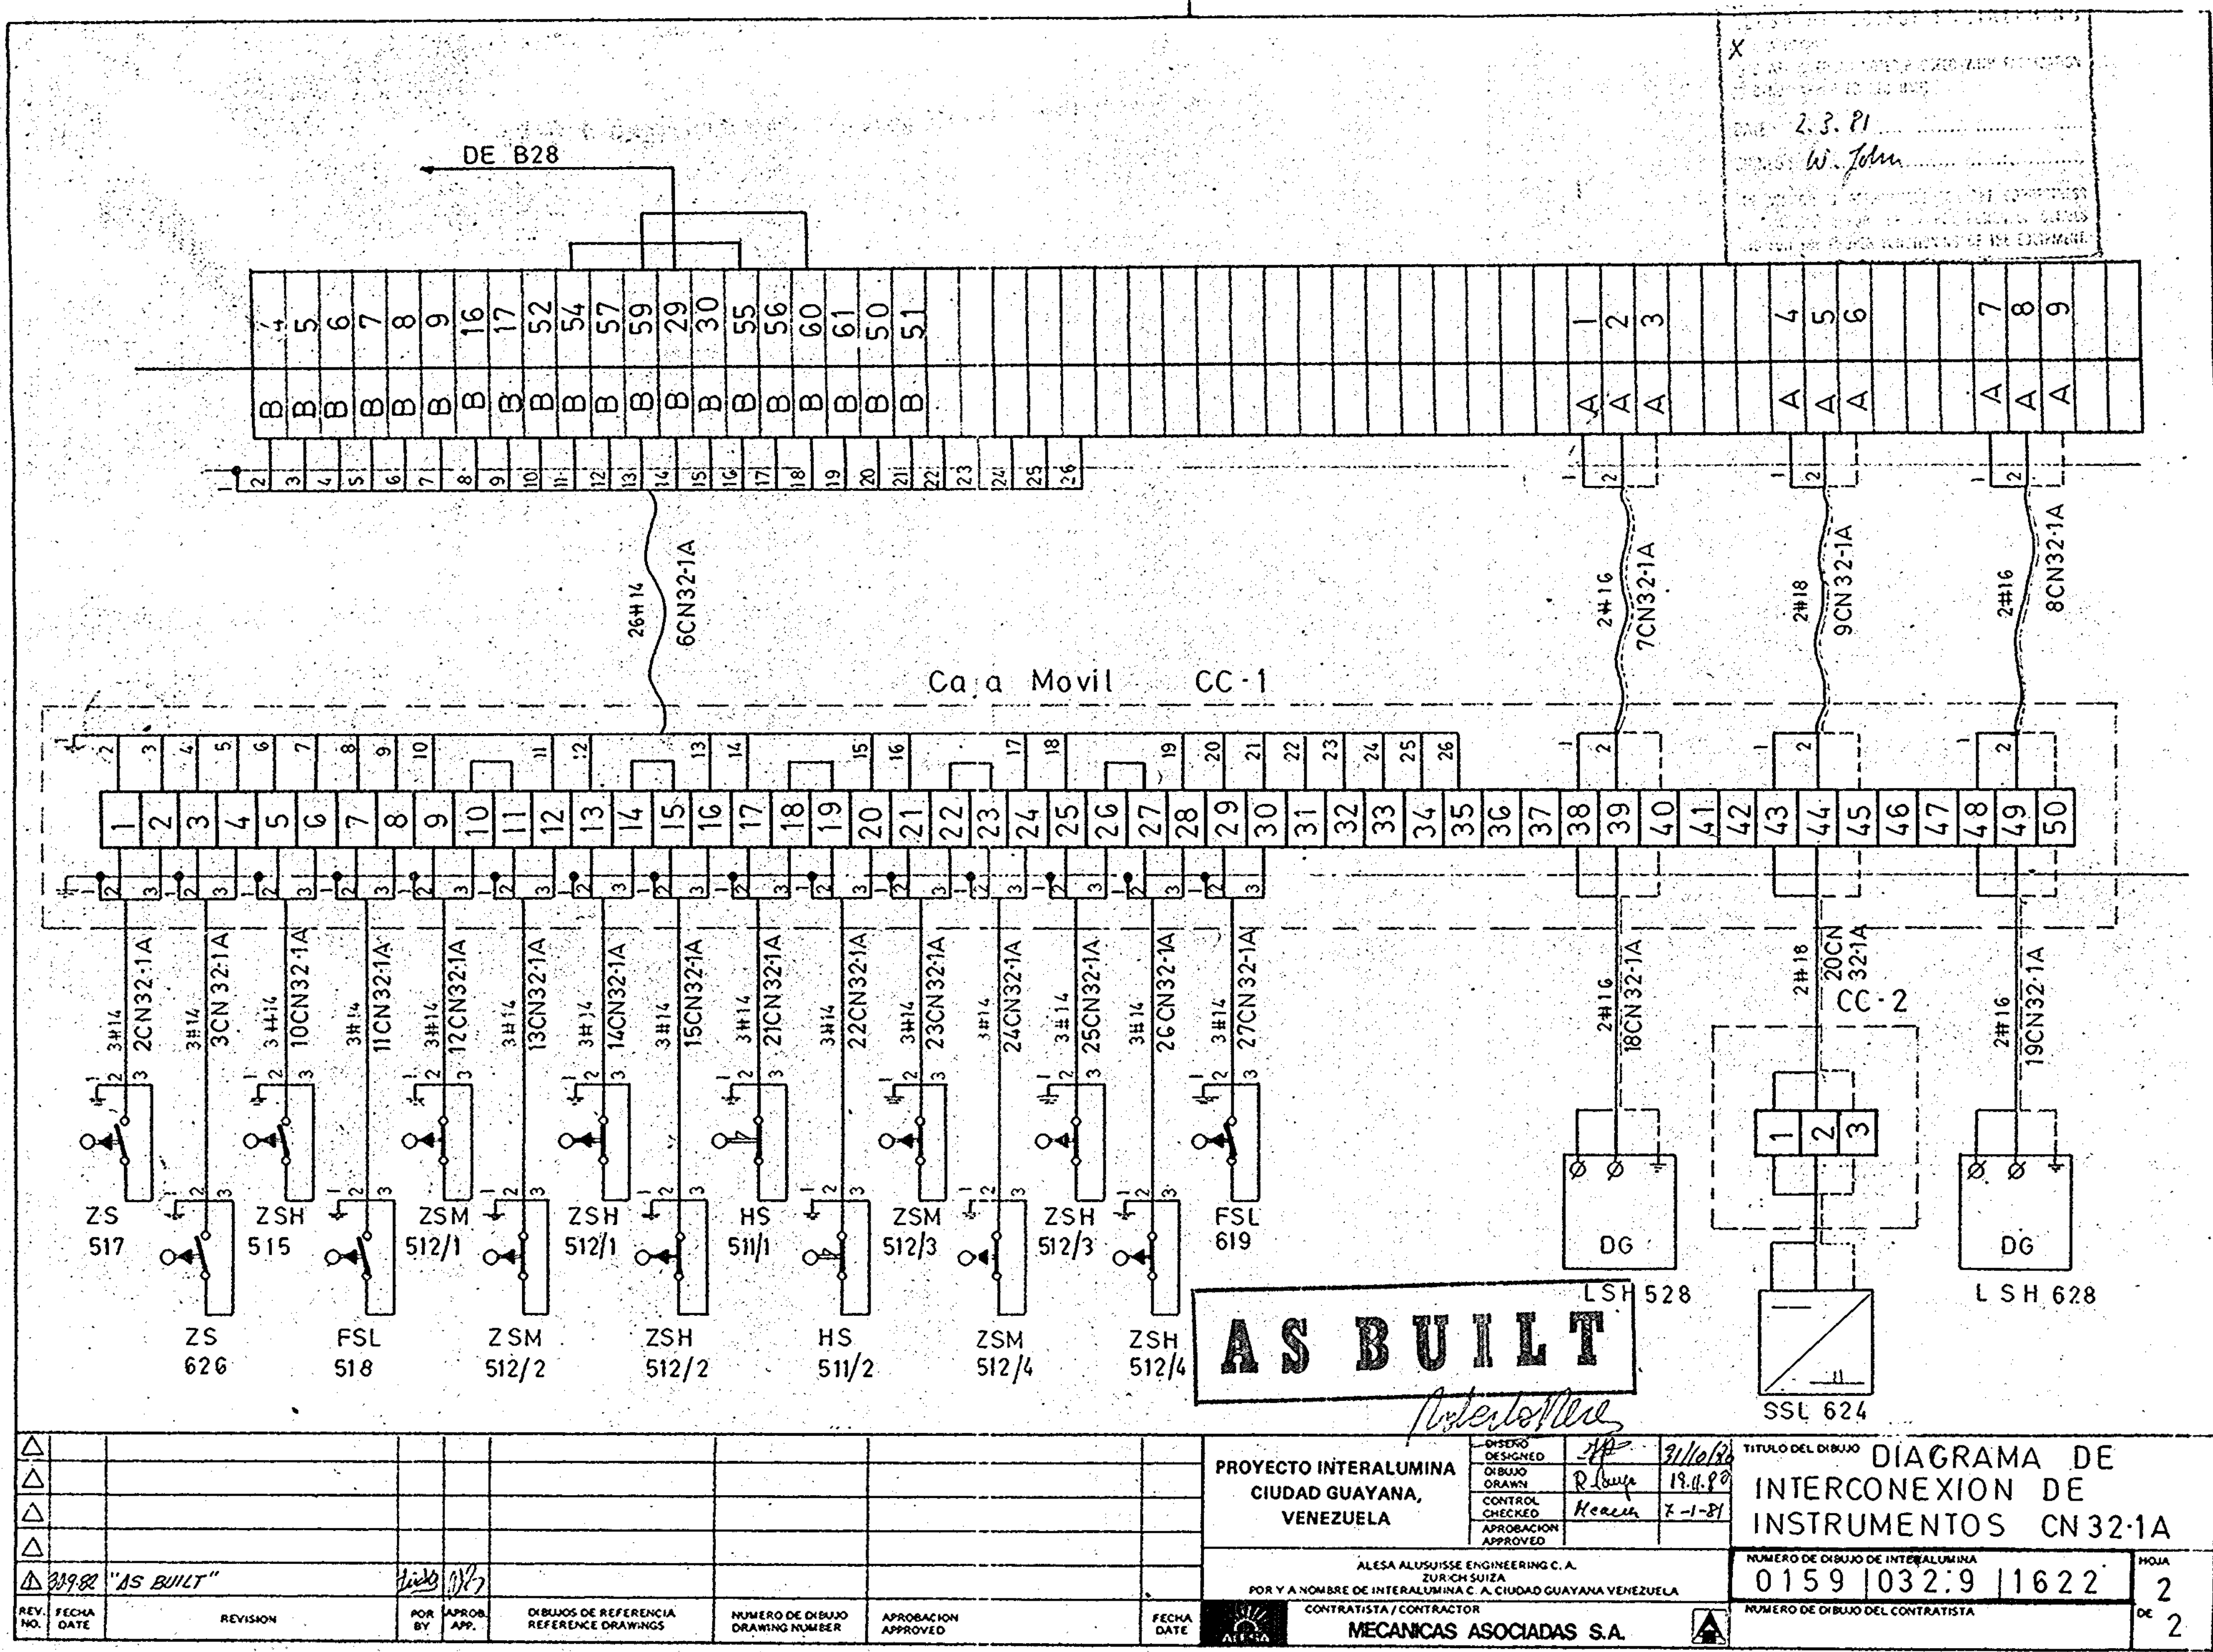


17-0159.0.32:9.1623 1/2



☐										PROYECTO INTERALUMINA CIUDAD GUAYANA, VENEZUELA	DISEÑO DESIGNED <i>JH</i> DIBUJO DRAWN <i>R. Bouys</i> CONTROL CHECKED <i>Herrera</i> APROBACION APPROVED <i>31/10/80</i> <i>20-11-80</i> <i>7-1-81</i>	TITULO DEL DIBUJO DIA GRAMA DE INTERCONEXION DE INSTRUMENTOS CN32-1B
☐												
☐												
☐												
☒	30982	"AS BUILT"		<i>tich</i>	<i>OK</i>					ALESA ALUSUISSE ENGINEERING C.A. ZURICH SUIZA POR Y A NOMBRE DE INTERALUMINA C.A. CIUDAD GUAYANA VENEZUELA	NUMERO DE DIBUJO DE INTERALUMINA 0159 0329 1623	HOJA 1
REV. NO.	FECHA DATE	REVISION	POR BY	APROB. APP.	DIBUJOS DE REFERENCIA REFERENCE DRAWINGS	NUMERO DE DIBUJO DRAWING NUMBER	APROBACION APPROVED	FECHA DATE		CONTRATISTA / CONTRACTOR MECANICAS ASOCIADAS S.A.		NUMERO DE DIBUJO DEL CONTRATISTA. DE 2

B-04-159-XX

12/2
12-0159.0.32:9.1623

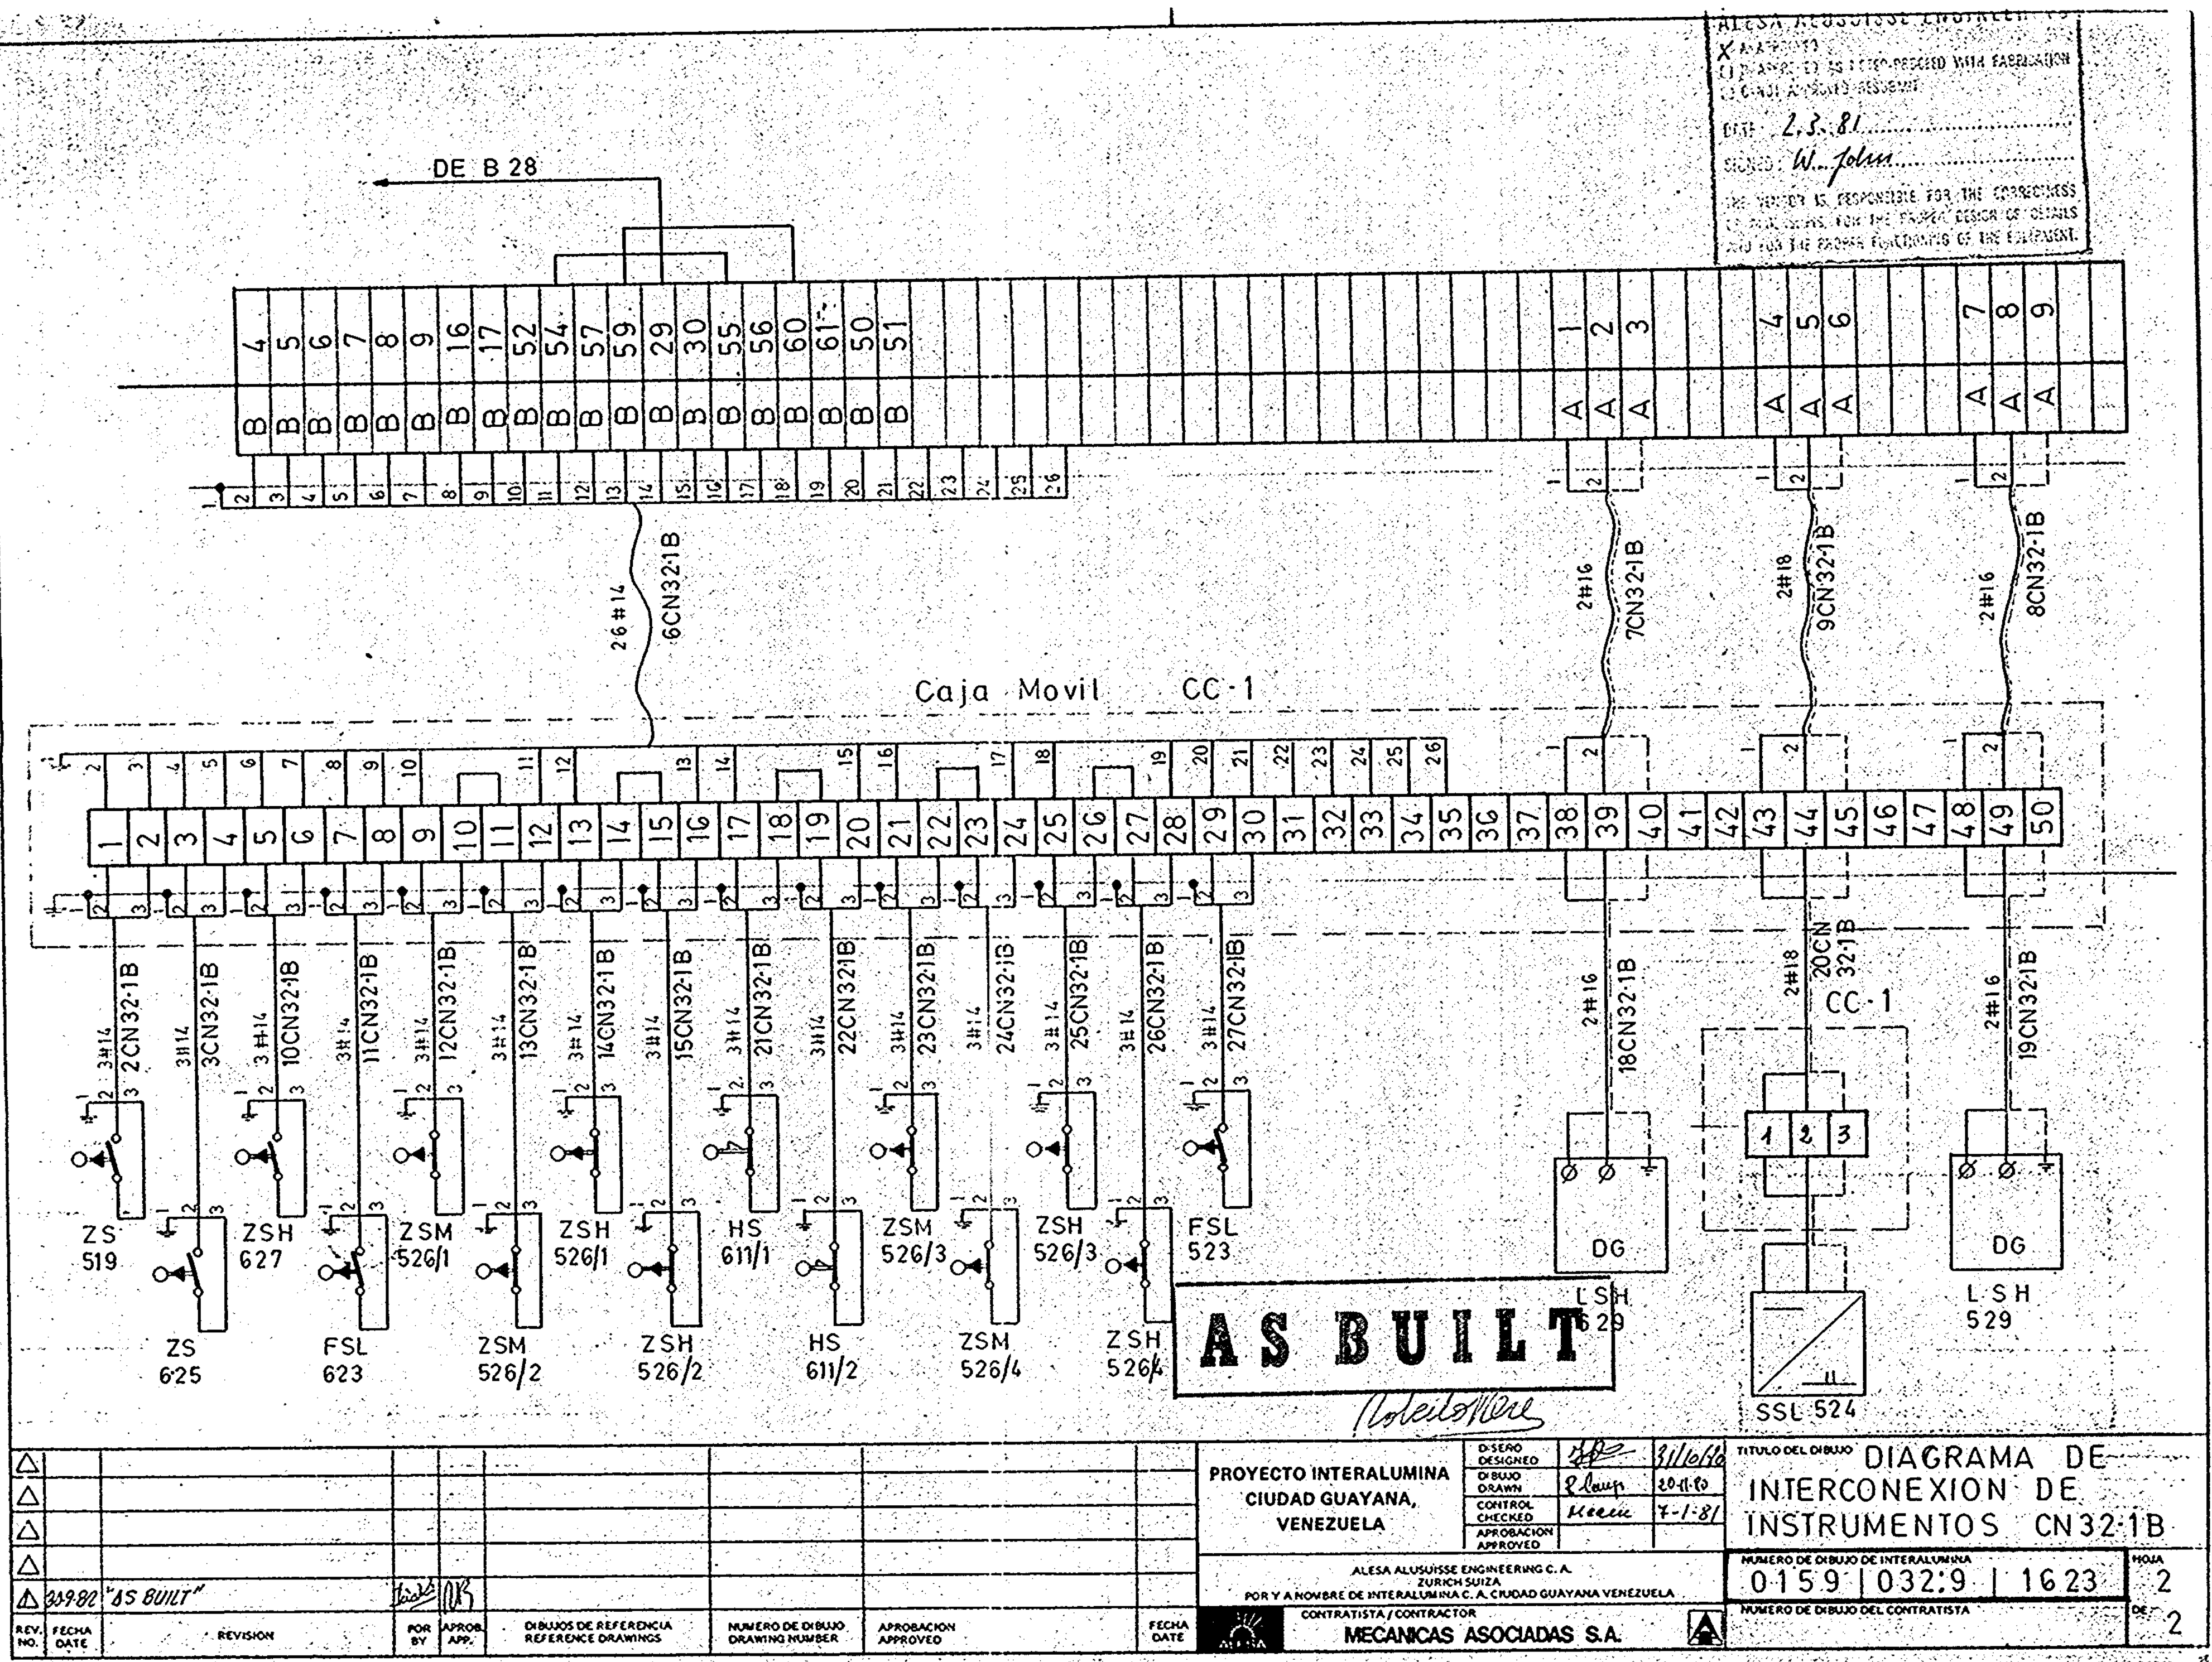


ALESA ALUSUISSE ENGINEERING C.A.
X-ANALYST
CIUDAD GUAYANA VENEZUELA
DATE 2.3.81
SIGNED: W. Jolan
THE SIGNER IS RESPONSIBLE FOR THE CORRECTNESS
OF THE DESIGN FOR THE PROJECT DESIGN OF DETAILS
AND FOR THE PROPER FUNCTIONING OF THE EQUIPMENT.

B-04-159-X

W-0159.0.32.9.1624/3

CAJA TERMINAL
CT 32-2A

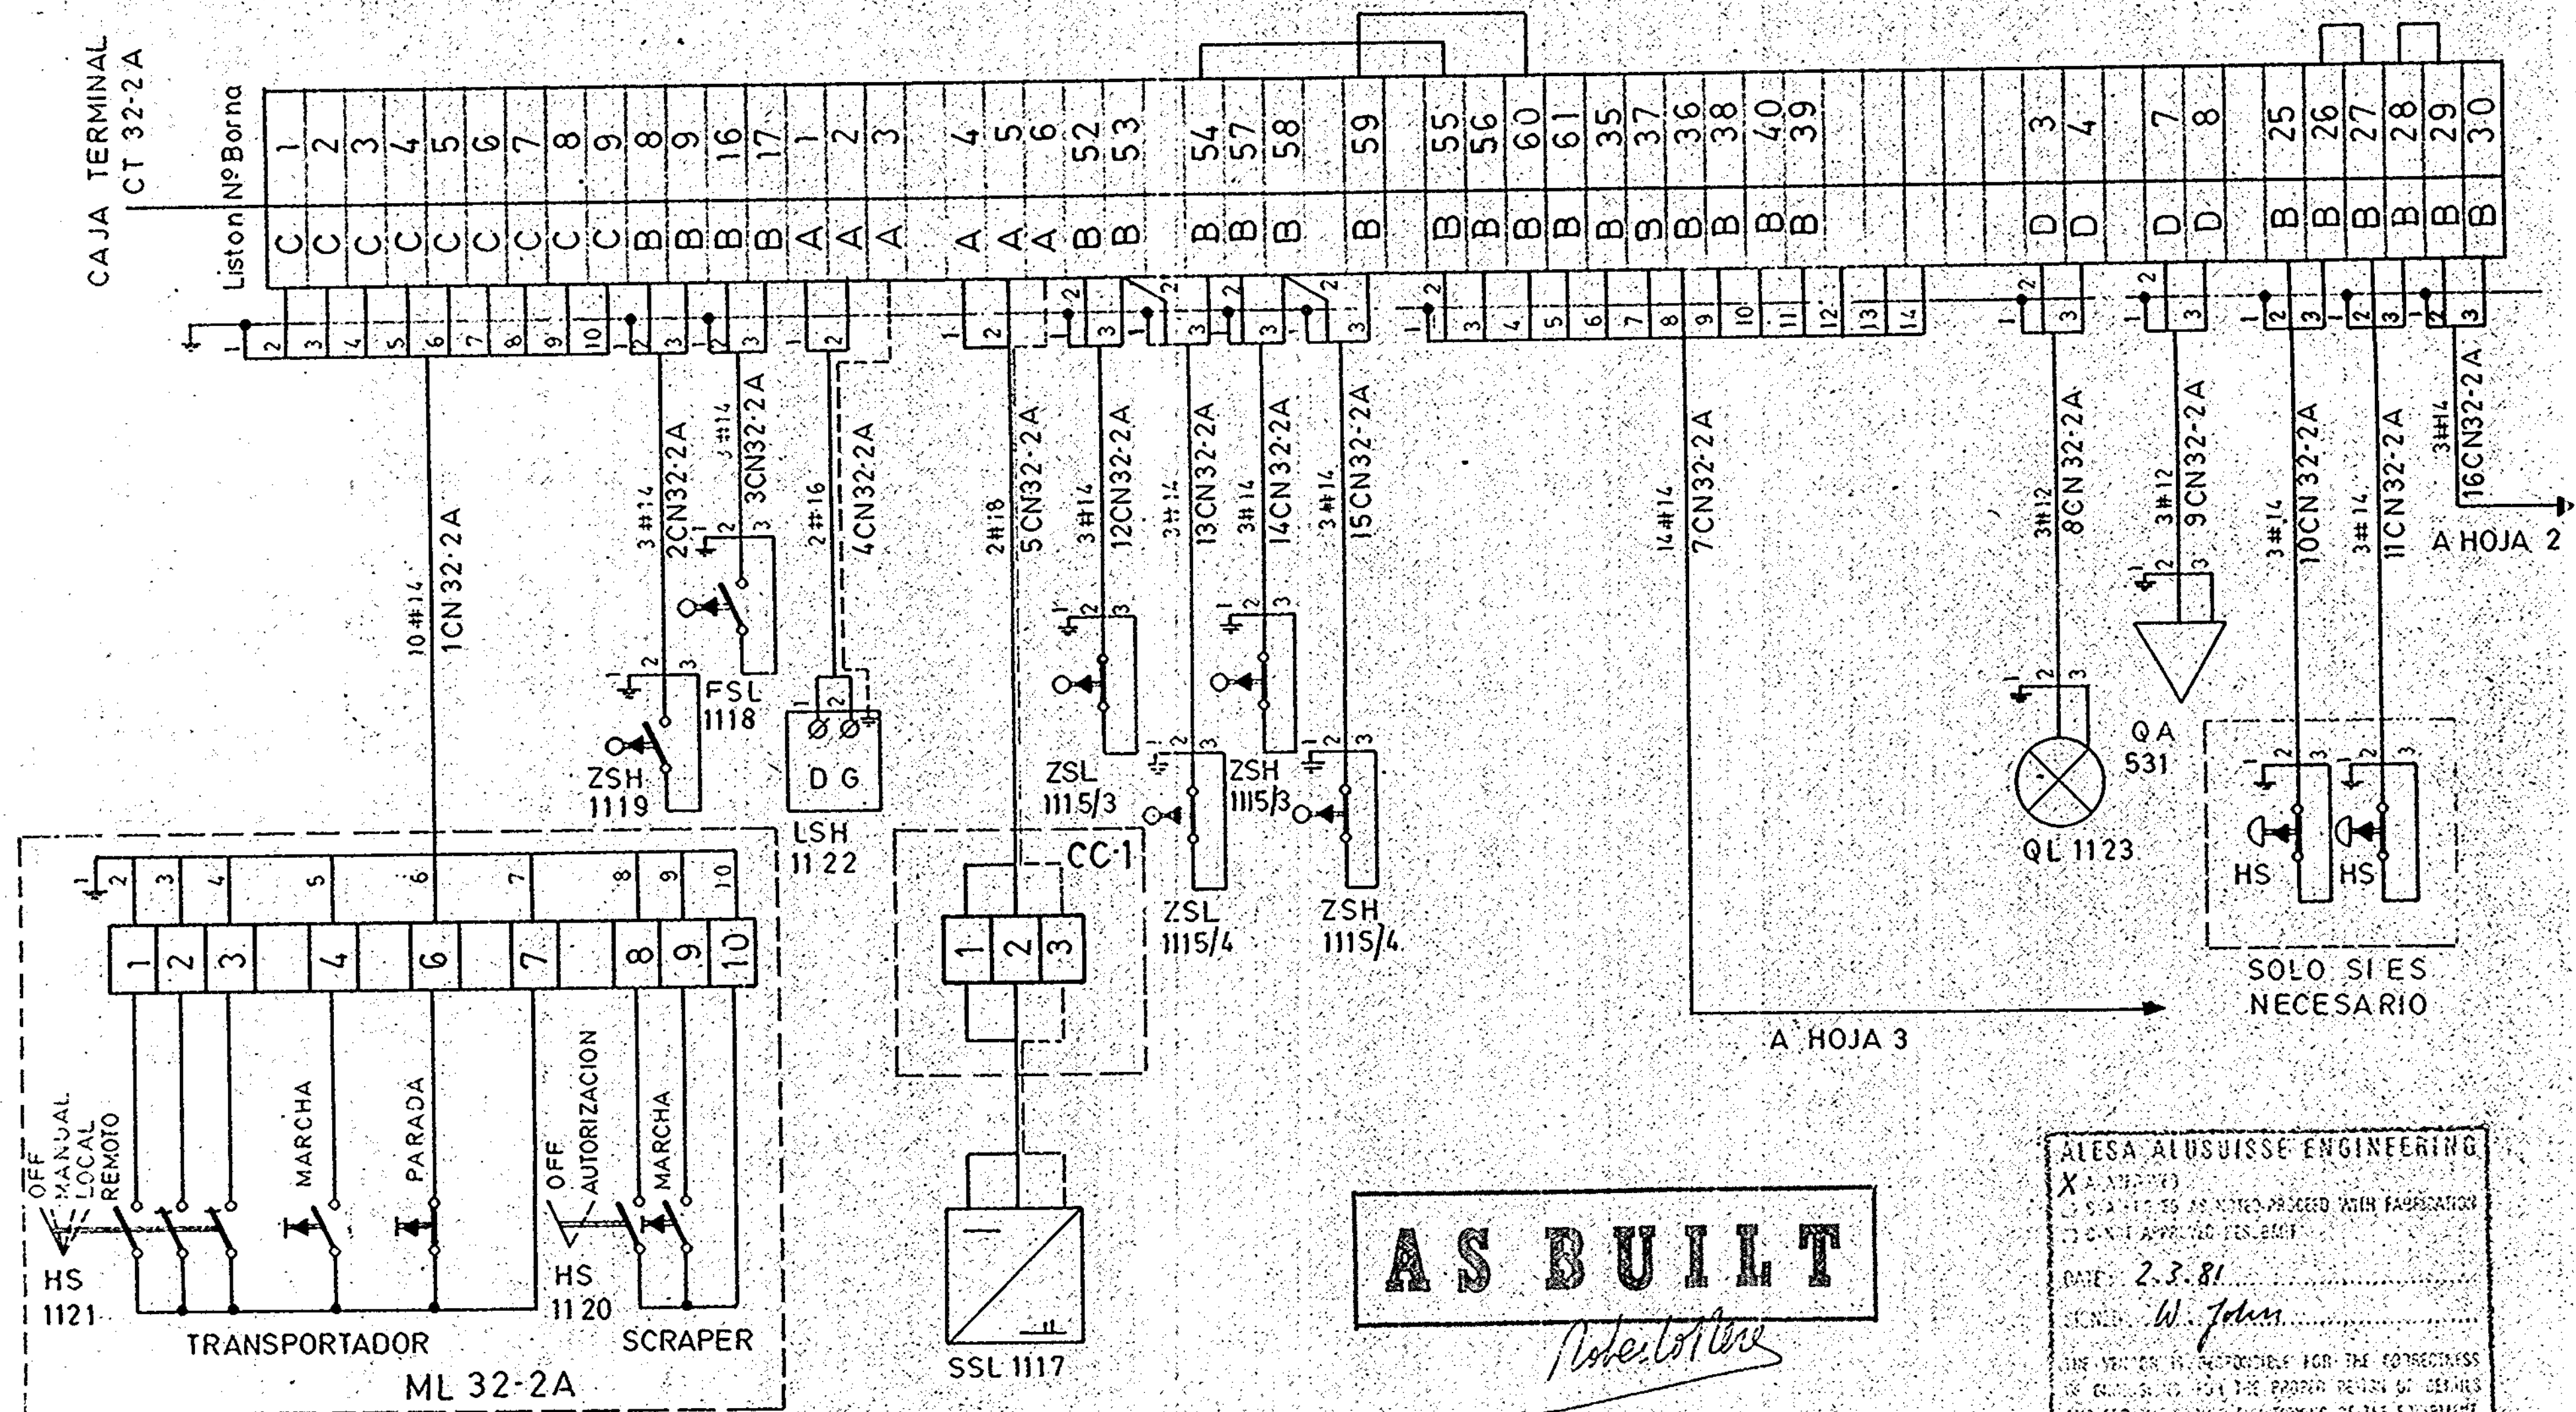

AS BUILT

ALESA ALUSUISSE ENGINEERING
X A. APPROVED
DESIGNED BY: R. B. APPROVED BY: R. B.
DATE: 2-3-81
SIGNATURE: W. John
THE SIGNATURE IS RESPONSIBLE FOR THE CORRECTNESS
OF THE DRAWING FOR THE PROPER DESIGN OF DETAILS
AND FOR THE PROPER FUNCTIONING OF THE EQUIPMENT.


REV. NO.	FECHA DATE	REVISION	FOR BY	APROB. APP.	DIBUJOS DE REFERENCIA REFERENCE DRAWINGS	NUMERO DE DIBUJO DRAWING NUMBER	APROBACION APPROVED	FECHA DATE	PROYECTO INTERALUMINA CIUDAD GUAYANA, VENEZUELA	DISENO DESIGNED DIBUJO DRAWN CONTROL CHECKED APROBACION APPROVED	FECHA DATE	TITULO DEL DIBUJO DIAGRAMA DE INTERCONEXION DE INSTRUMENTOS CN32-2A	NUMERO DE DIBUJO DE INTERALUMINA 0159 1032.9 1624	HOJA DE 1 3
1	9/10/85	PY # 032-075-85	DM	GM							3/10/82			
2	3/9/82	"AS BUILT"	DM	GM							2-11-80			
3											7-4-81			

MECANICAS ASOCIADAS S.A.



ALESA ALUSUISSE ENGINEERING C.A.
ZURICH SUIZA
POR Y A NOMBRE DE INTERALUMINA C.A. CIUDAD GUAYANA VENEZUELA
CONTRATISTA / CONTRACTOR

[illegible]

HP-0159.0.32:9.1624 $\frac{3}{3}$

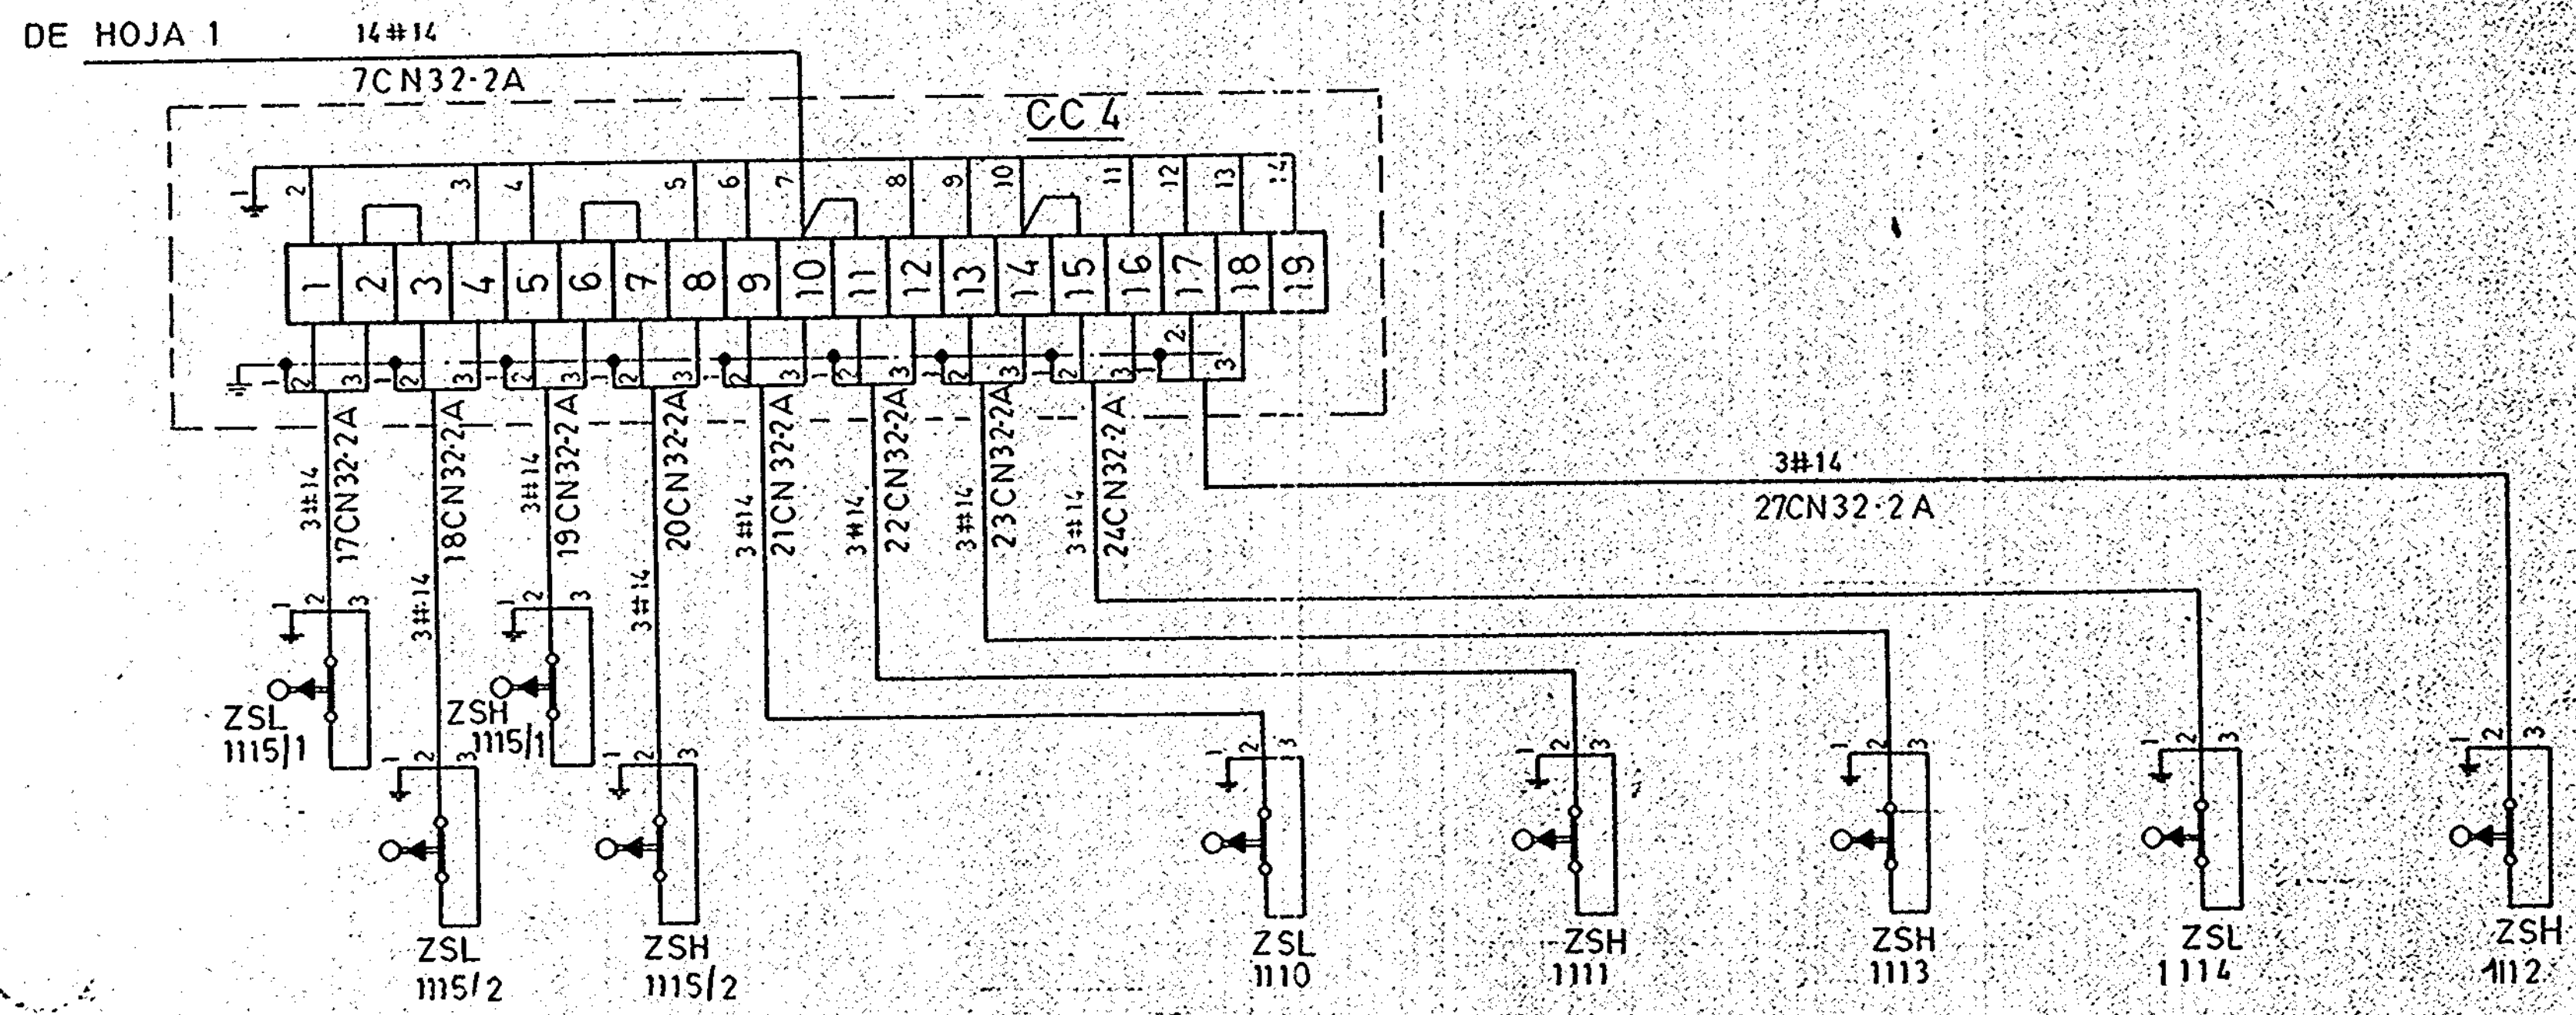[illegible]

DE HOJA 1 3#14
15CN32-2B

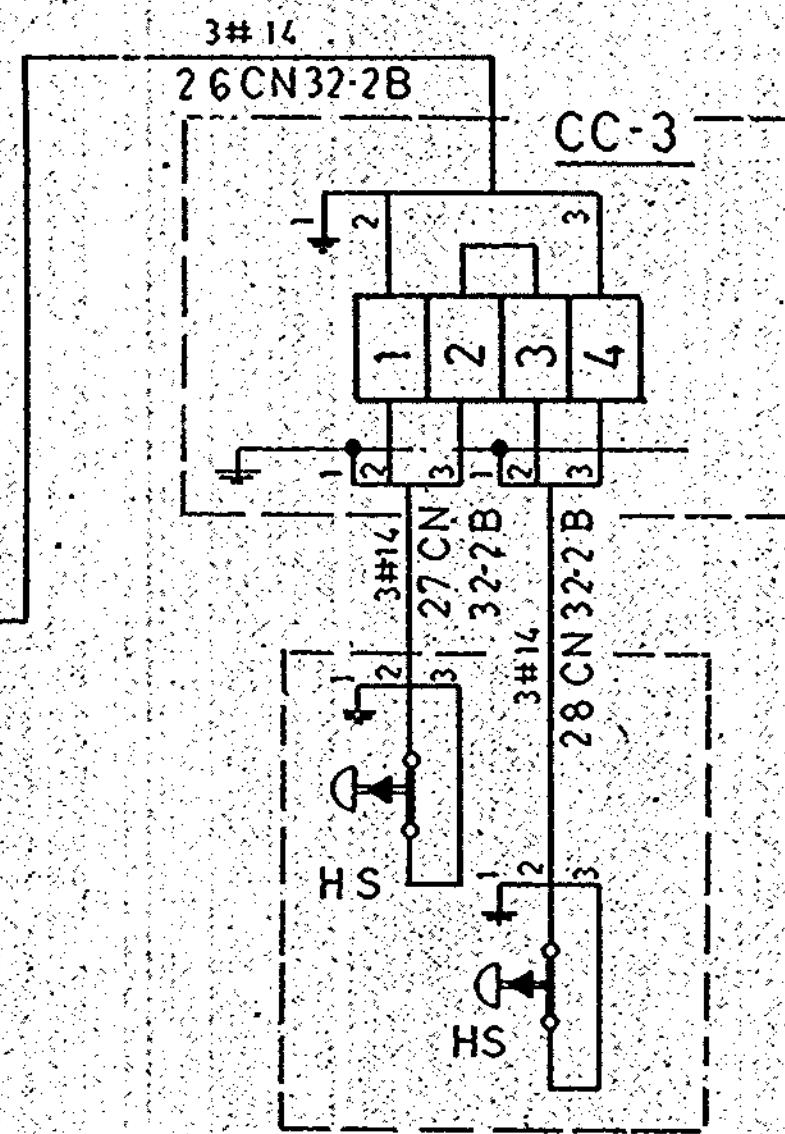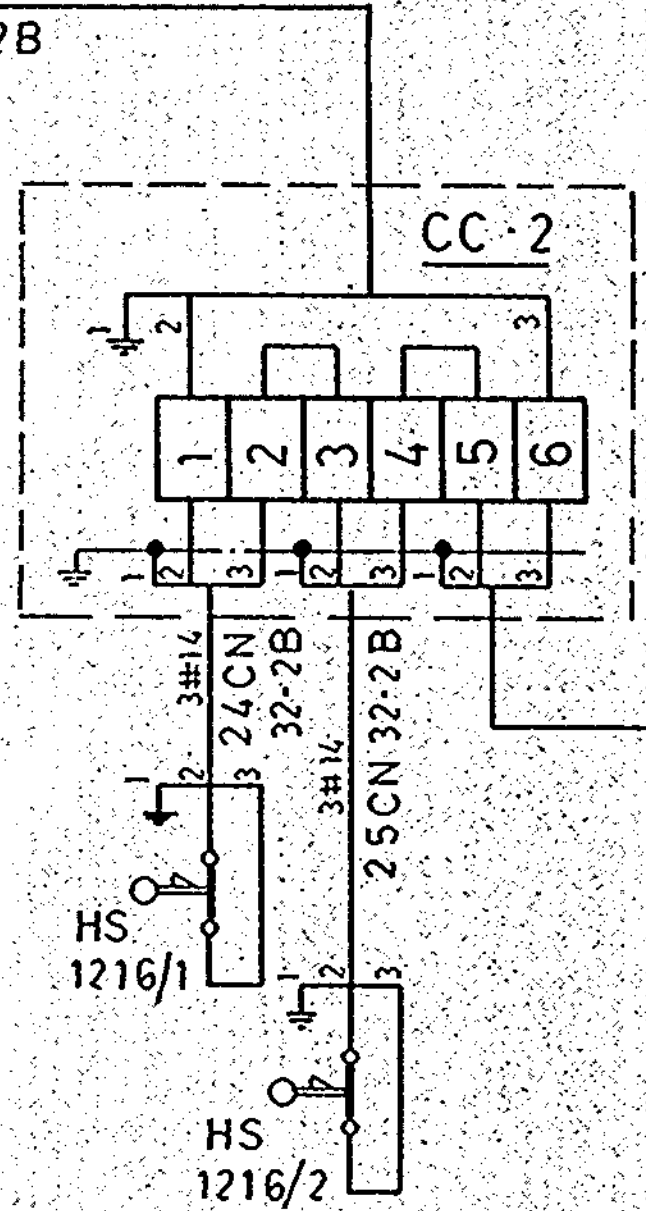

SOLO SI ES
NECESARIO

AS BUILT

Noted here

ALESA ALUSISSE ENGINEERING
X
DATE 2.3.81
SIGN: W. John
THE SIGNOR IS RESPONSIBLE FOR THE CORRECTNESS
OF DIMENSIONS FOR THE PROPER ACTION OF THE
AND FOR THE PROPER FUNCTIONING OF THE EQUIPMENT.

REV. NO.	FECHA DATE	REVISION	POR BY	APROB. APP.	DIBUJOS DE REFERENCIA REFERENCE DRAWINGS	NUMERO DE DIBUJO DRAWING NUMBER	APROBACION APPROVED	FECHA DATE	PROYECTO INTERALUMINA CIUDAD GUAYANA, VENEZUELA	DISEÑO DESIGNED	DIBUJO DRAWN	CONTROL CHECKED	APROBACION APPROVED	TITULO DEL DIBUJO DIAGRAMA DE INTERCONEXION DE INSTRUMENTOS CN32-2B	NUMERO DE DIBUJO DE INTERALUMINA 0159 032:9 1625	HOJA 2
30982		AS BUILT														3

13-04-159-XX
13-0159.0.32:9.1625 2/3

VF-0159.0.32:9.6-25 3/3

Shed with any other the shed which





WP-0159.0.32:7.1626 3/3

☐																			
☐																			
☐																			
☒	7/10/85	PY # 032-075-85	DM	JGM															
☒	30-9-80	"AS BUILT"	LKJ	OR															
REV. NO.	FECHA DATE	REVISION	POR BY	APROB. APP.	DIBUJOS DE REFERENCIA REFERENCE DRAWINGS	NUMERO DE DIBUJO DRAWING NUMBER	APROBACION APPROVED	FECHA DATE											
									PROYECTO INTERALUMINA CIUDAD GUAYANA, VENEZUELA TITULO DEL DIBUJO DIAGRAMA DE INTERCONEXION DE INSTRUMENTOS CN 32-2C						NÚMERO DE DIBUJO DE INTERALUMINA 0159 032:9 1626		HOJA 3		
									ALISA ALUISISSE ENGINEERING C.A. ZÜRICH SUIZA POR Y A NOMBRE DE INTERALUMINA C.A. CIUDAD GUAYANA VENEZUELA										
									CONTRATISTA / CONTRACTOR MECANICAS ASOCIADAS S.A.						NÚMERO DE DIBUJO DEL CONTRATISTA		DE 3		



CAJA TERMINAL
CT 32-102

Liston Nº Borna

1	C
2	C
3	C
4	C
5	C
6	C
7	C
8	C
9	C
10	C
11	B
12	B
13	B
14	B
15	B
16	B
17	B
18	A
19	A
20	A
21	A
22	A
23	A
24	A
25	B
26	B
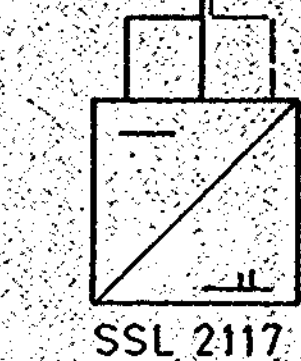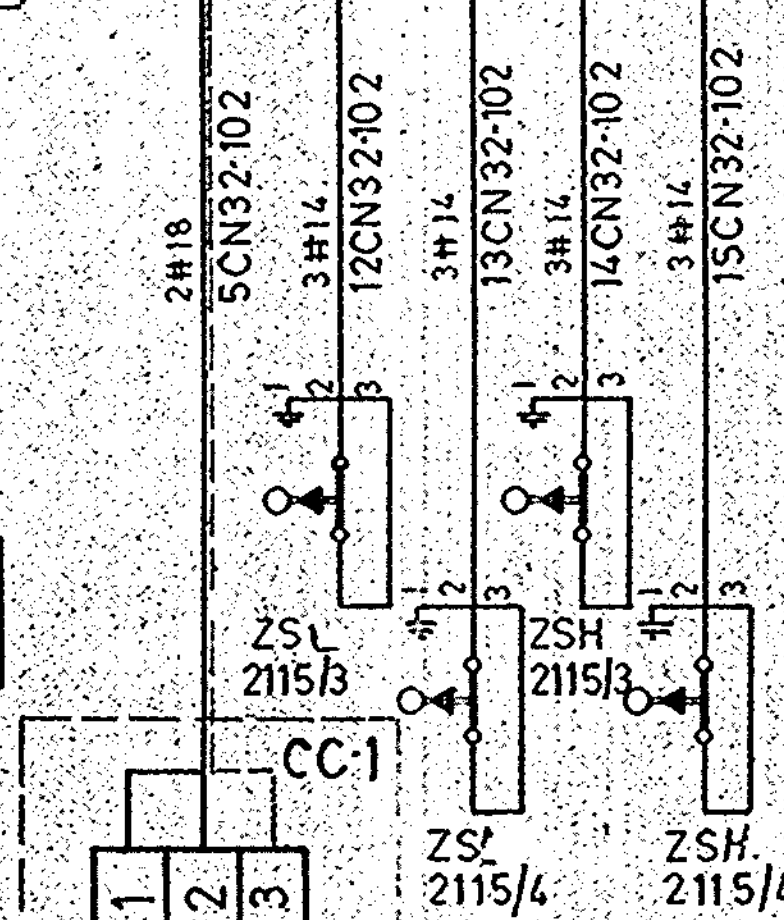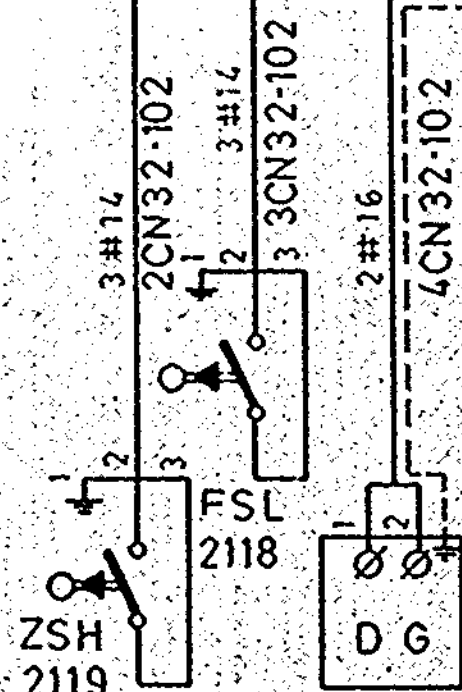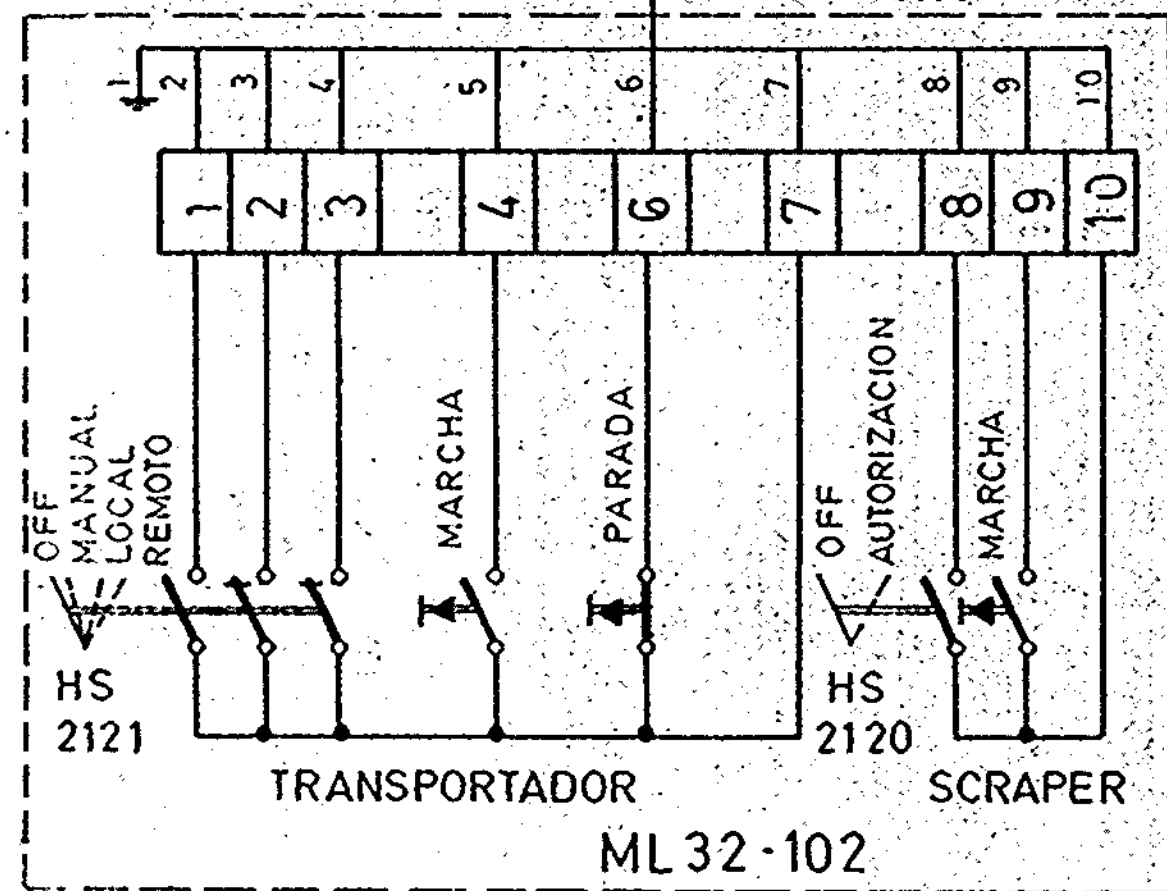

AS BUILT
Roberto Mera

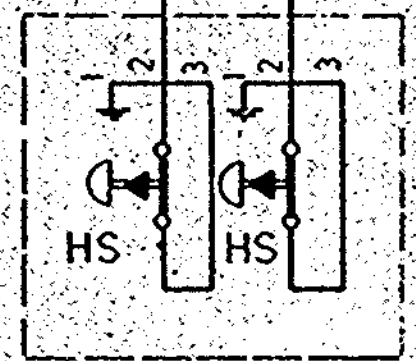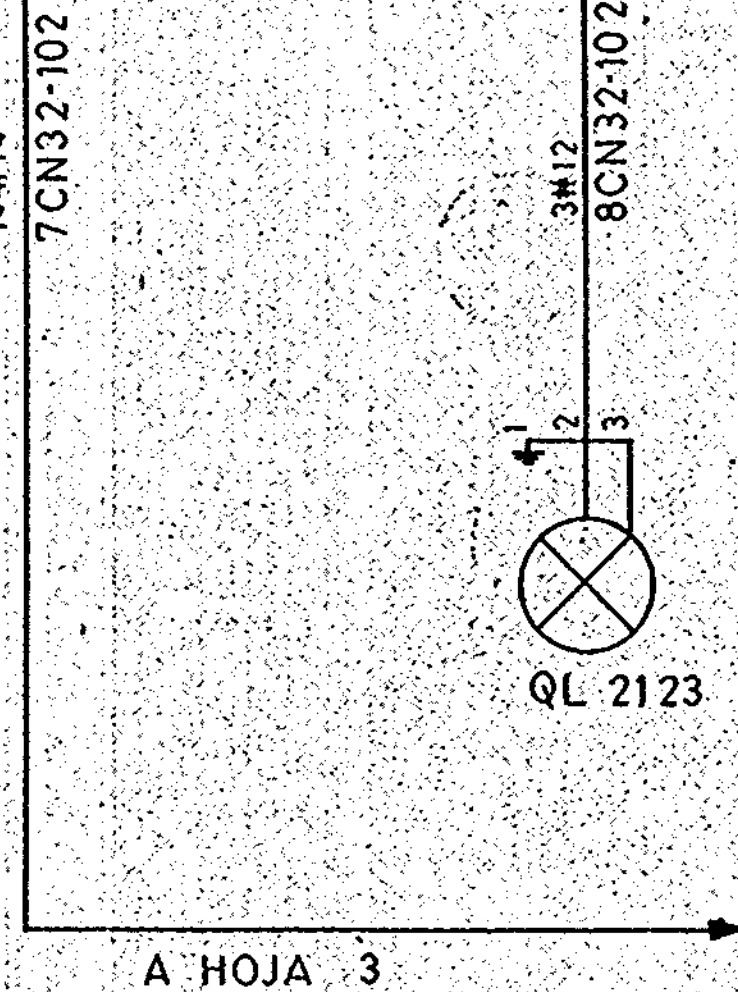

ALESA ALUSUISSE ENGINEERING
X INTERVIEW
AS BUILT TO AS BUILT PROCEDURE WITH EXPLANATION
TO BE APPROVED - RESUMIT
DATE: 2-3-81
SIGNED: W. J. J.
THE VENDOR IS RESPONSIBLE FOR THE CORRECTNESS
OF DIMENSIONS FOR THE PROPER FIT OF DETAILS
AND FOR THE PROPER FUNCTIONING OF THE EQUIPMENT.

REV. NO.	FECHA DATE	REVISION	FOR BY	APROB. APP.	DIBUJOS DE REFERENCIA REFERENCE DRAWINGS	NUMERO DE DIBUJO DRAWING NUMBER	APROBACION APPROVED	FECHA DATE
1	9/10/80	PP # 032-075-85	DM	JG				
2	30-9-80	"AS BUILT"						

PROYECTO INTERALUMINA CIUDAD GUAYANA, VENEZUELA		DISEÑO DESIGNED: <i>W. J. J.</i> DIBUJO DRAWN: <i>R. J. J.</i> CONTROL CHECKED: <i>W. J. J.</i> APROBACION APPROVED: <i>W. J. J.</i>	TITULO DEL DIBUJO: DIAGRAMA DE INTERCONEXION DE INSTRUMENTOS CN32-102 NUMERO DE DIBUJO DE INTERALUMINA: 0159 032.9 1627 NUMERO DE DIBUJO DEL CONTRATISTA:
ALESA ALUSUISSE ENGINEERING C.A. ZURICH SUIZA POR Y A NOMBRE DE INTERALUMINA C.A. CIUDAD GUAYANA VENEZUELA		CONTRATISTA / CONTRACTOR: MECANICAS ASOCIADAS S.A.	
		HOJA 1 DE 3	

13-04-159-XX
13-0159.0.32.9.1627 1/3

304-159-XX

180159.0.32.9.1627/3


ALESA ALUSUISSE ENGINEERING
 X APROBADO
 B APROBADO ES NOTO PROYECTO WITH FABRICATION
 C NOT APROBADO REVISION
 DATE: 2.3.81
 SIGNATURE: W. John
 THE DESIGNER IS RESPONSIBLE FOR THE CORRECTNESS
 OF DIMENSIONS FOR THE PROPER FUNCTION OF DETAILS
 AND FOR THE PROPER FUNCTIONING OF THE EQUIPMENT

DE HOJA 1

14#14

7CN 32-102

CC-4

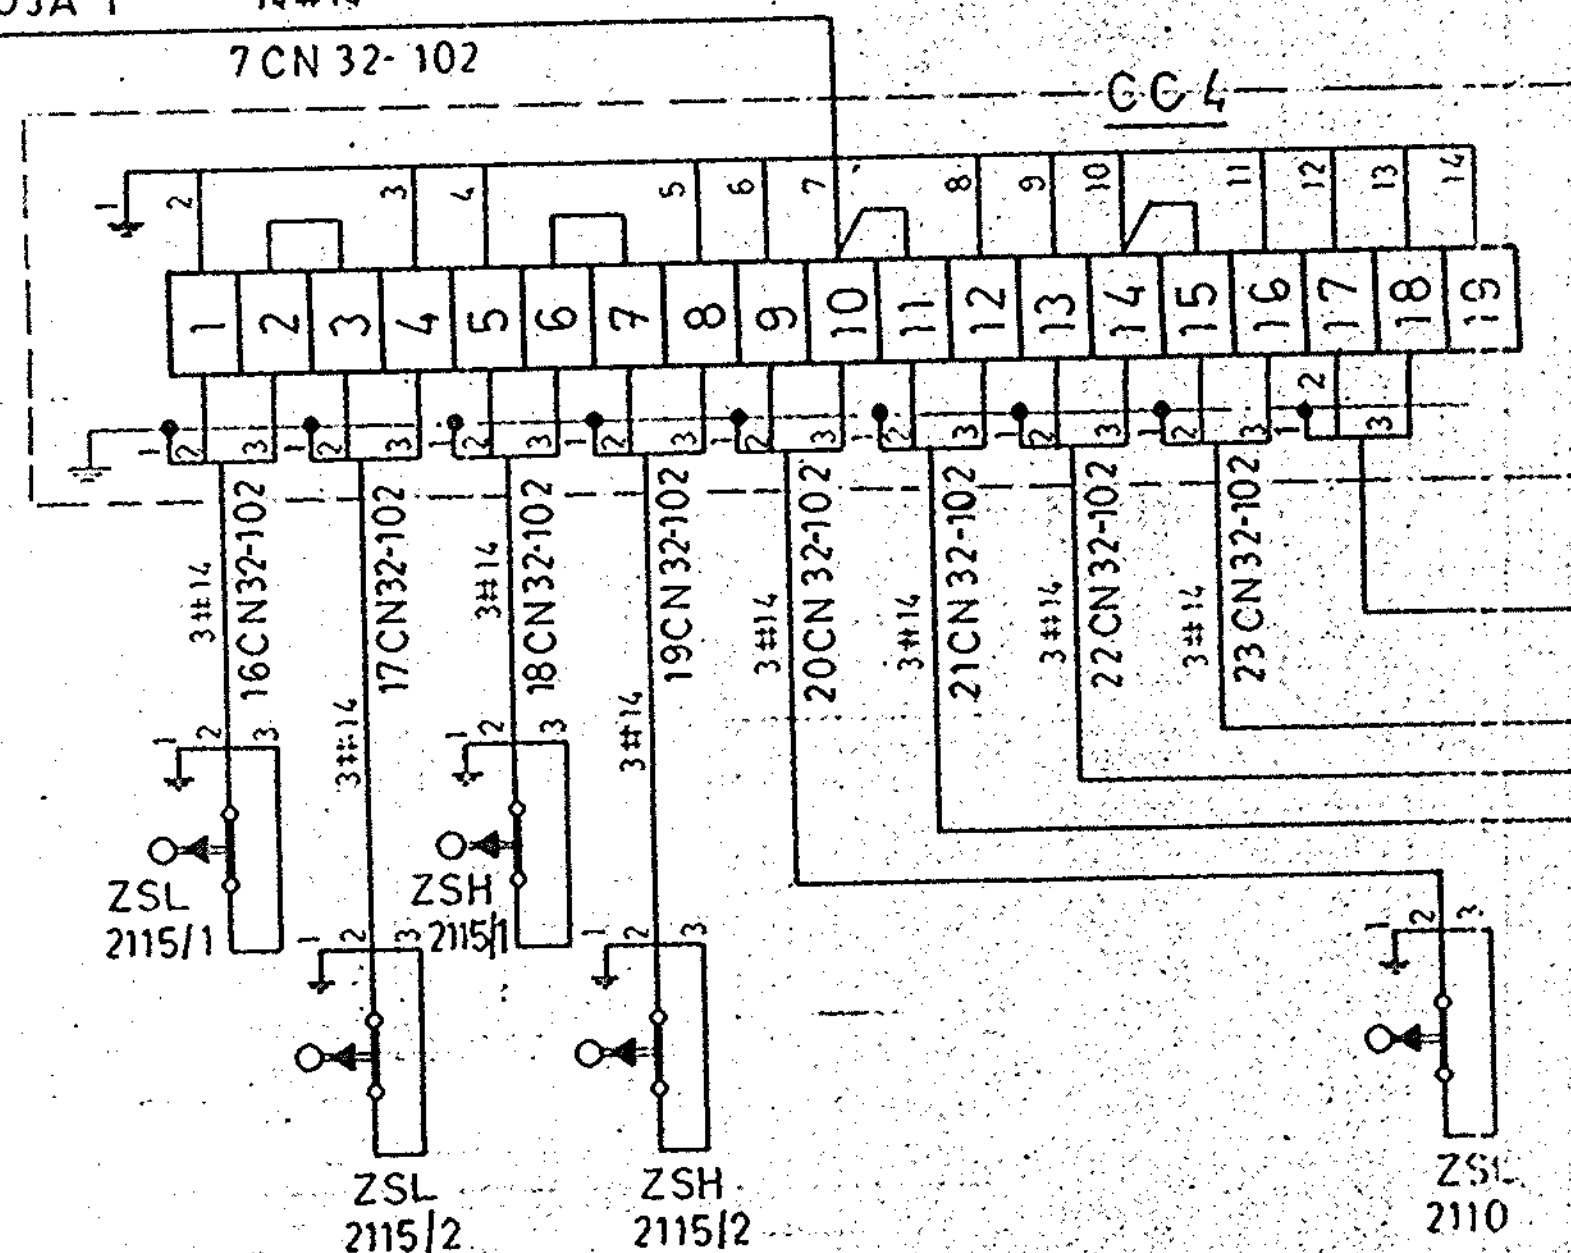

AS BUILT

PROYECTO INTERALUMINA
 CIUDAD GUAYANA,
 VENEZUELA

DESIGNER: [Signature]
 DRAWN: [Signature]
 CONTROL CHECKED: [Signature]
 APROBACION APPROVED: [Signature]

TITULO DEL DIBUJO: DIAGRAMA DE
 INTERCONEXION DE
 INSTRUMENTOS CN 32-102

ALESA ALUSUISSE ENGINEERING C.A.
 ZURICH SUIZA
 POR Y A NOMBRE DE INTERALUMINA C.A. CIUDAD GUAYANA VENEZUELA
 CONTRATISTA / CONTRACTOR
MECANICAS ASOCIADAS S.A.


NUMERO DE DIBUJO DE INTERALUMINA:
 0159 | 032:9 | 1627
 NUMERO DE DIBUJO DEL CONTRATISTA

HOJA
 3
 DE
 3

REV. NO.	FECHA DATE	REVISION	PCR BY	APROB. APP.	DIBUJOS DE REFERENCIA REFERENCE DRAWINGS	NUMERO DE DIBUJO DRAWING NUMBER	APROBACION APPROVED	FECHA DATE
1								
2								
3								
3-04-159-XA

42-0159-032-9-1654

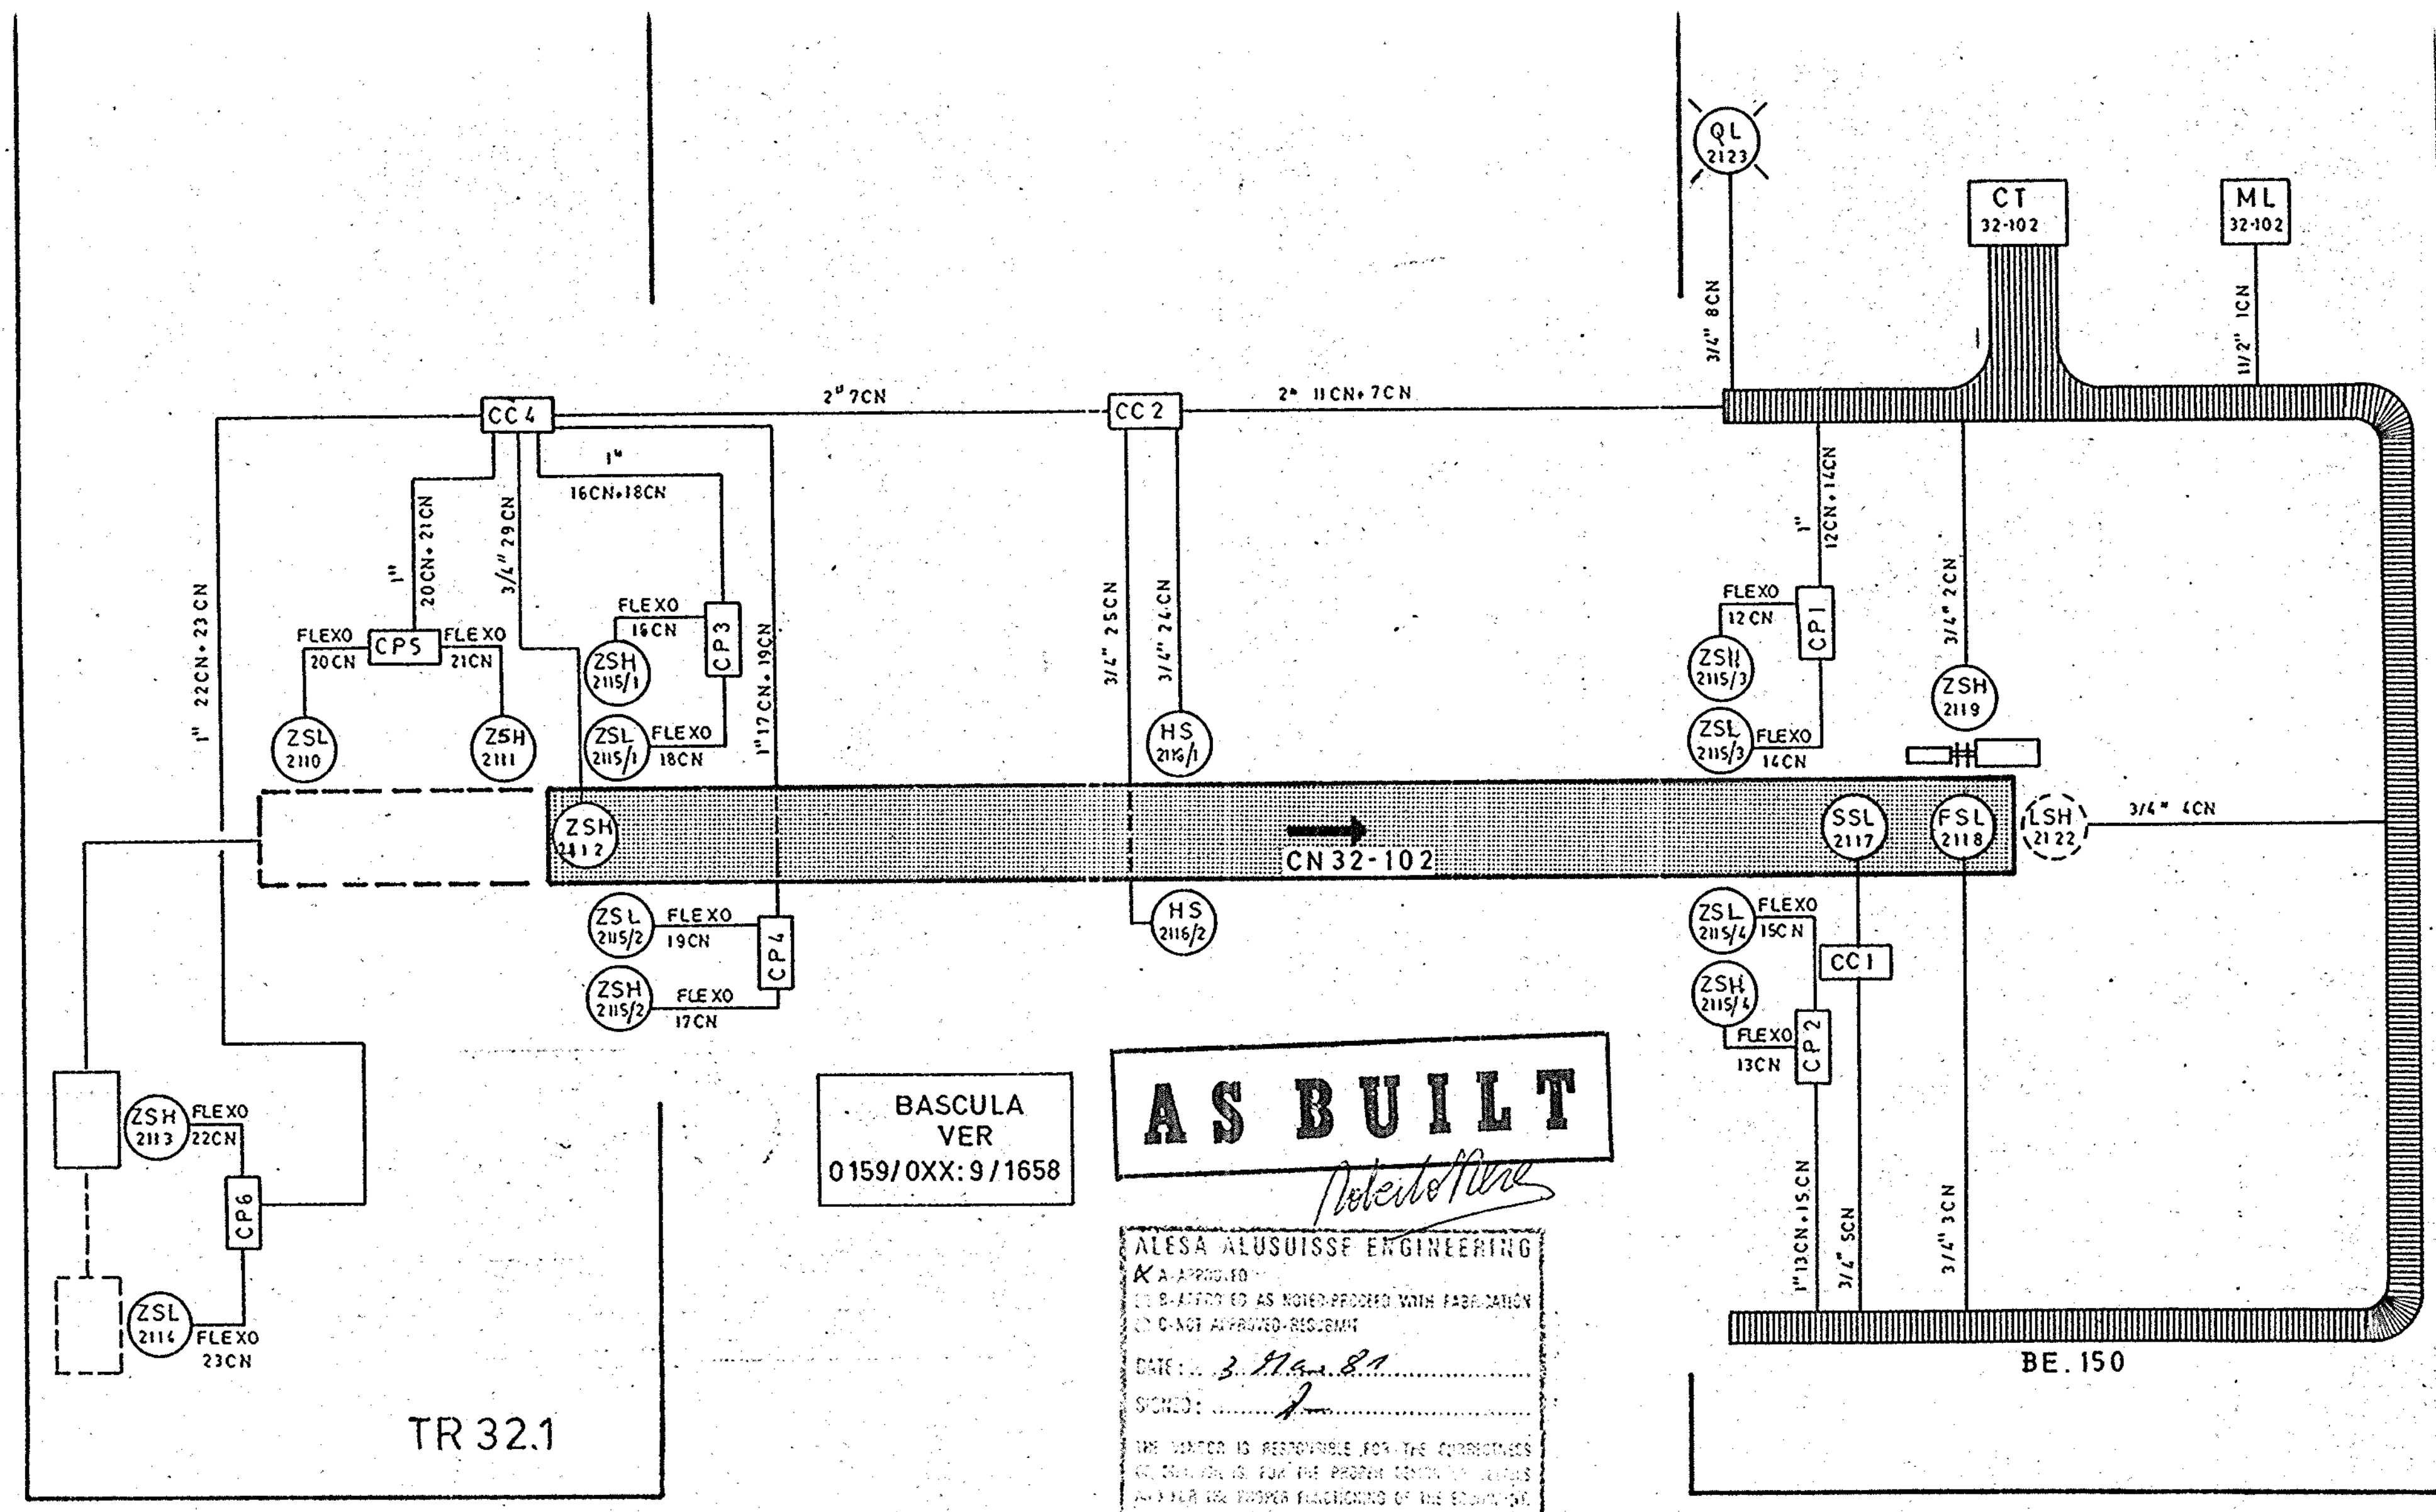

BASCULA
VER
0159/0XX:9/1658

AS BUILT

ALESA ALUSUISSE ENGINEERING
K A-APPROVED
L B-APPROVED AS NOTED-PROCEED WITH FABRICATION
C-C-NOT APPROVED-RESUBMIT
DATE: 3. 11. 81
SIGNED: [Signature]
THE UNDERSIGNED IS RESPONSIBLE FOR THE CORRECTNESS
OF THE DESIGN FOR THE PROJECT DESCRIBED IN THE
TITLE AND FOR THE PROPER FUNCTIONING OF THE EQUIPMENT.

REV. NO.	FECHA DATE	REVISION	FOR BY	APPROB. APP.	DIBUJOS DE REFERENCIA REFERENCE DRAWINGS	NUMERO DE DIBUJO DRAWING NUMBER	APROBACION APPROVED	FECHA DATE	PROYECTO INTERALUMINA CIUDAD GUAYANA, VENEZUELA	DISEÑO DESIGNED 8/1/81	TITULO DEL DIBUJO TRANSPORTADOR CN 32-102 ESQUEMA DE INSTALACION
1	3/10/81	PY # 032-075-85	DM	SGH						30.1.81	
2	20-9-81	"AS BUILT"	SGH	SGH						7-1-81	
ALESA ALUSUISSE ENGINEERING C.A. ZURICH SUIZA POR Y A NOMBRE DE INTERALUMINA C.A. CIUDAD GUAYANA VENEZUELA										NUMERO DE DIBUJO DE INTERALUMINA 0159 032:9 1654	
CONTRATISTA / CONTRACTOR MECANICAS ASOCIADAS S.A.										NUMERO DE DIBUJO DEL CONTRATISTA	